


SUITE 210
AS BUILT - 1 OF 1
8510 MCALPINE PARK DRIVE, CHARLOTTE, NC
896 RSF
SCALE: 1/8" = 1'-0"
DATE: JUNE 28, 2022

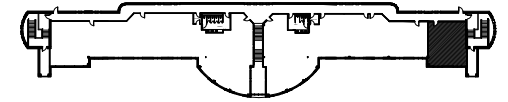

KEY PLAN

