


FOR LEASE

Arrowhead Medical Plaza II

18700 N 64TH DRIVE, GLENDALE, AZ 85308

Suite 100 As Built

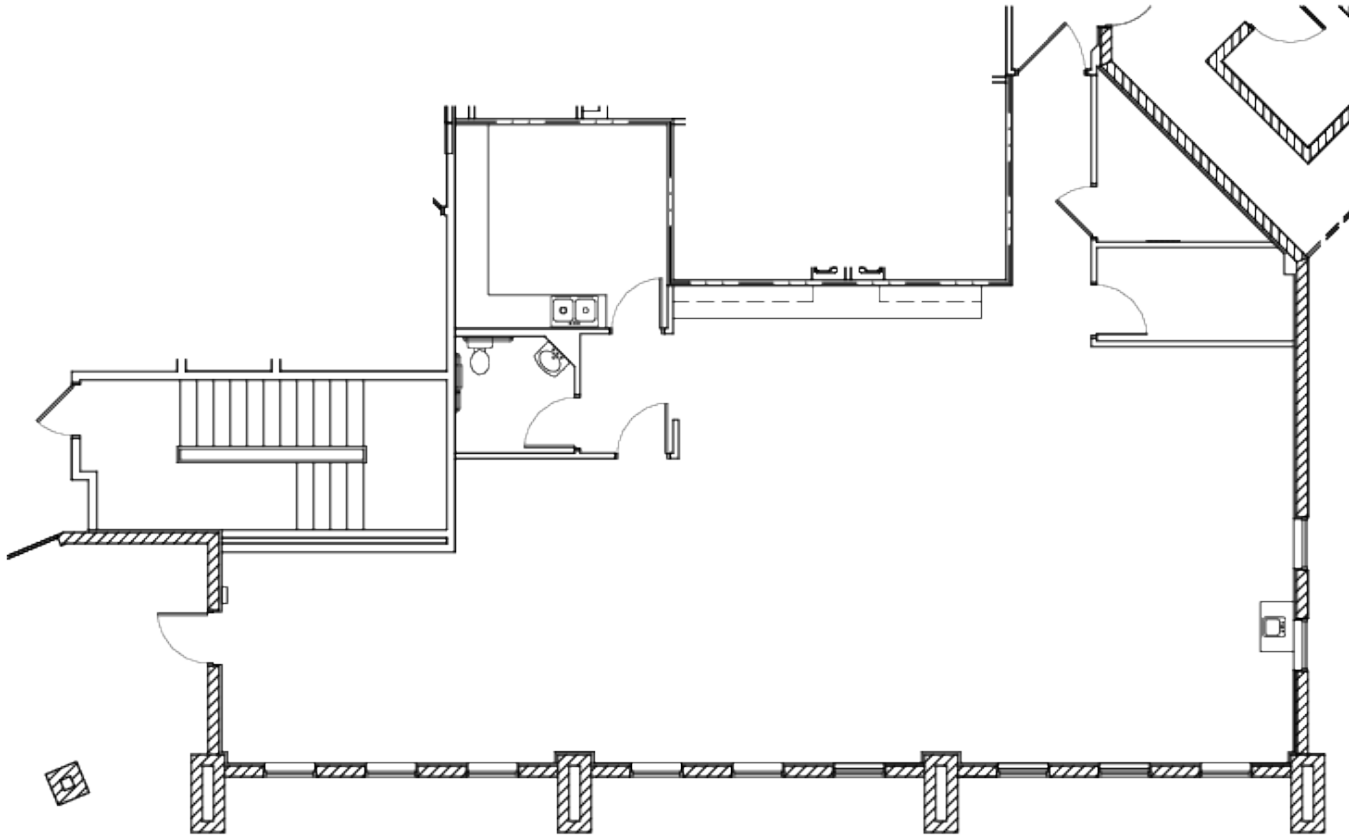

2,215

SQUARE FEET

PERRY GABUZZI, CCIM
602.513.5116
perry.gabuzzi@kidder.com

RACHAEL THOMPSON
602.513.5122
rachael.thompson@kidder.com

KIDDER.COM

This information supplied herein is from sources we deem reliable. It is provided without any representation, warranty, or guarantee, expressed or implied as to its accuracy. Prospective Buyer or Tenant should conduct an independent investigation and verification of all matters deemed to be material, including, but not limited to, statements of income and expenses. Consult your attorney, accountant, or other professional advisor.

km Kidder
Mathews