


1 1ST FLOOR AS-BUILT PLAN
 NOT TO SCALE
 3029 SOUTH SHERWOOD FOREST BLVD.
 BATON ROUGE, LOUISIANA 70816

CRESS & LOPRESTO ARCHITECTS L.L.C.
 A PROFESSIONAL ARCHITECTURAL CORPORATION
 3084 WESTFORK DRIVE, SUITE C
 BATON ROUGE, LOUISIANA 70816
 (225) 293-6040 FAX (225) 293-6045



5704

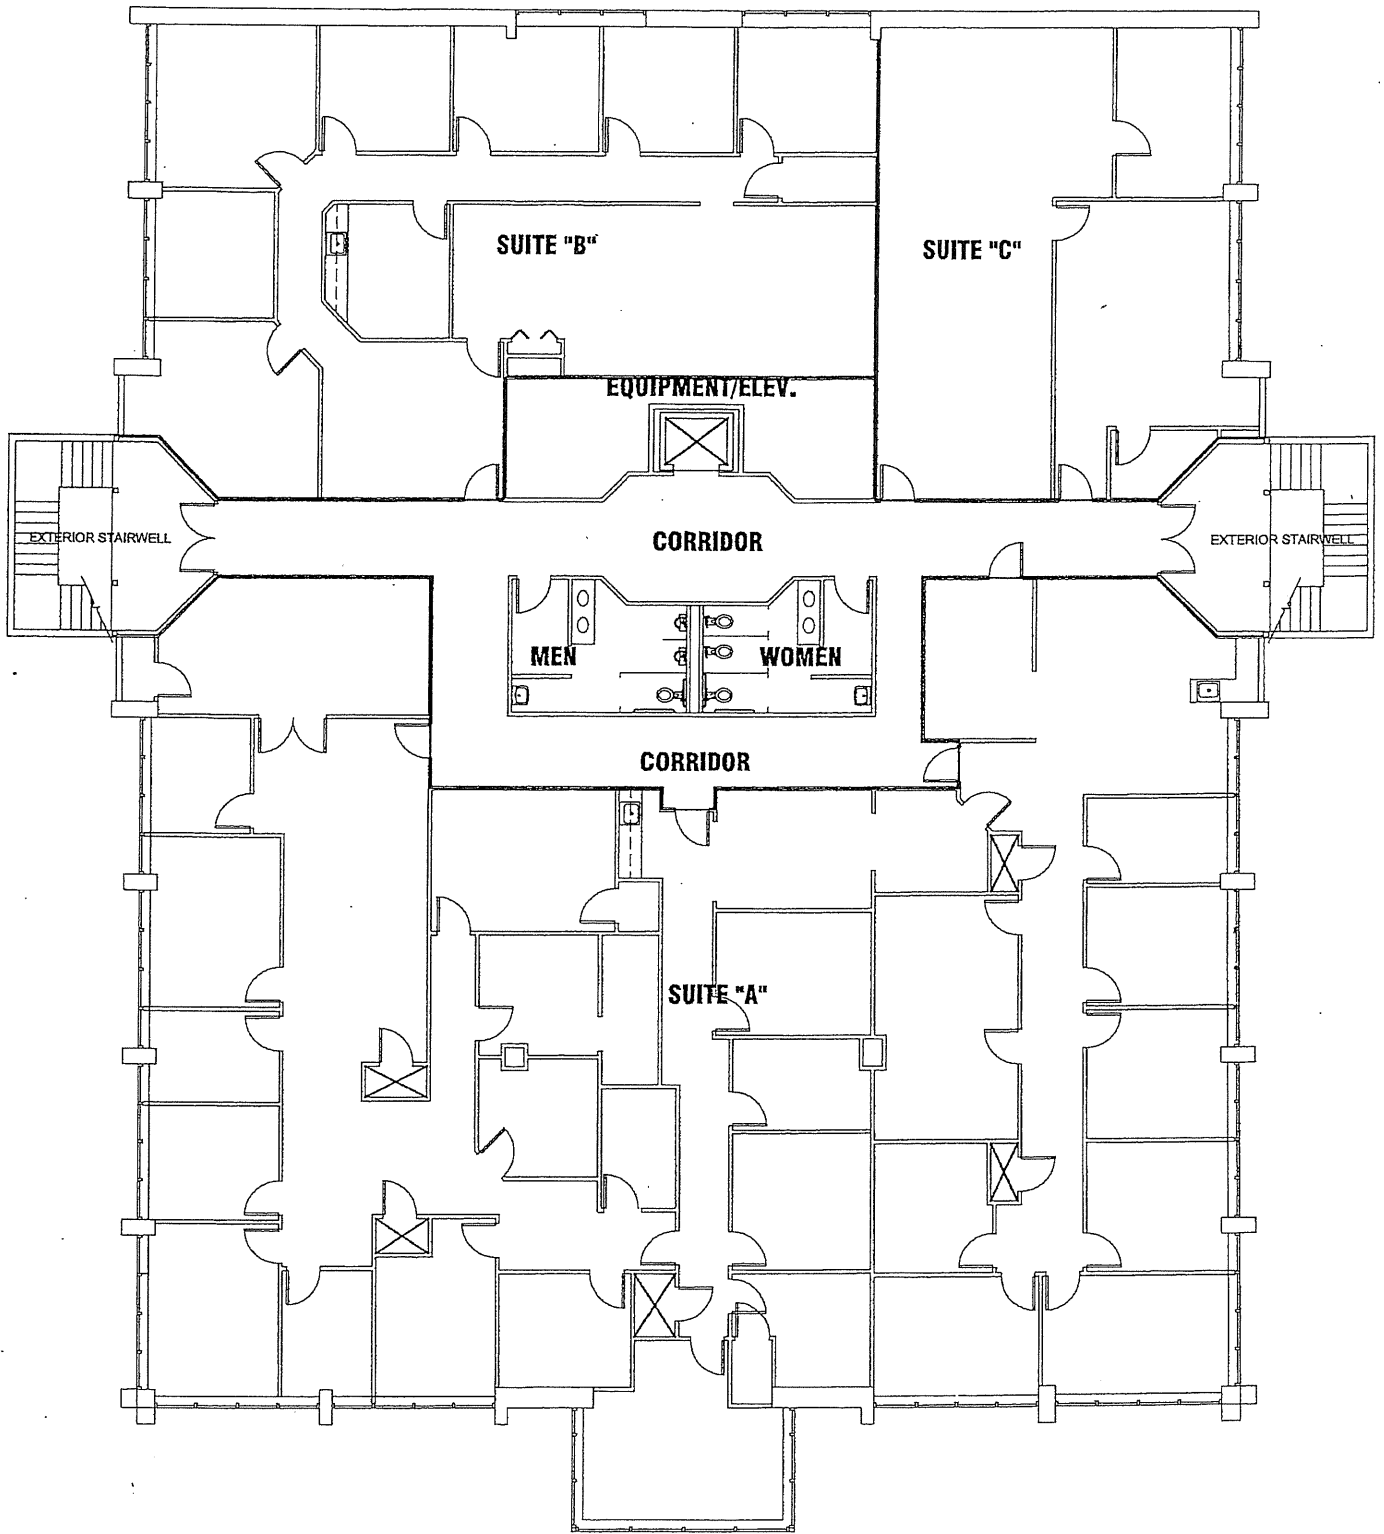

1 2ND FLOOR AS-BUILT PLAN
 NOT TO SCALE
 3029 SOUTH SHERWOOD FOREST BLVD.
 BATON ROUGE, LOUISIANA 70816

CRESS & LOPRESTO
ARCHITECTS L.L.C.
 A PROFESSIONAL ARCHITECTURAL CORPORATION
 3084 WESTFORK DRIVE, SUITE C
 BATON ROUGE, LOUISIANA 70816
 (225) 293-6040 FAX (225) 293-6045



12,000

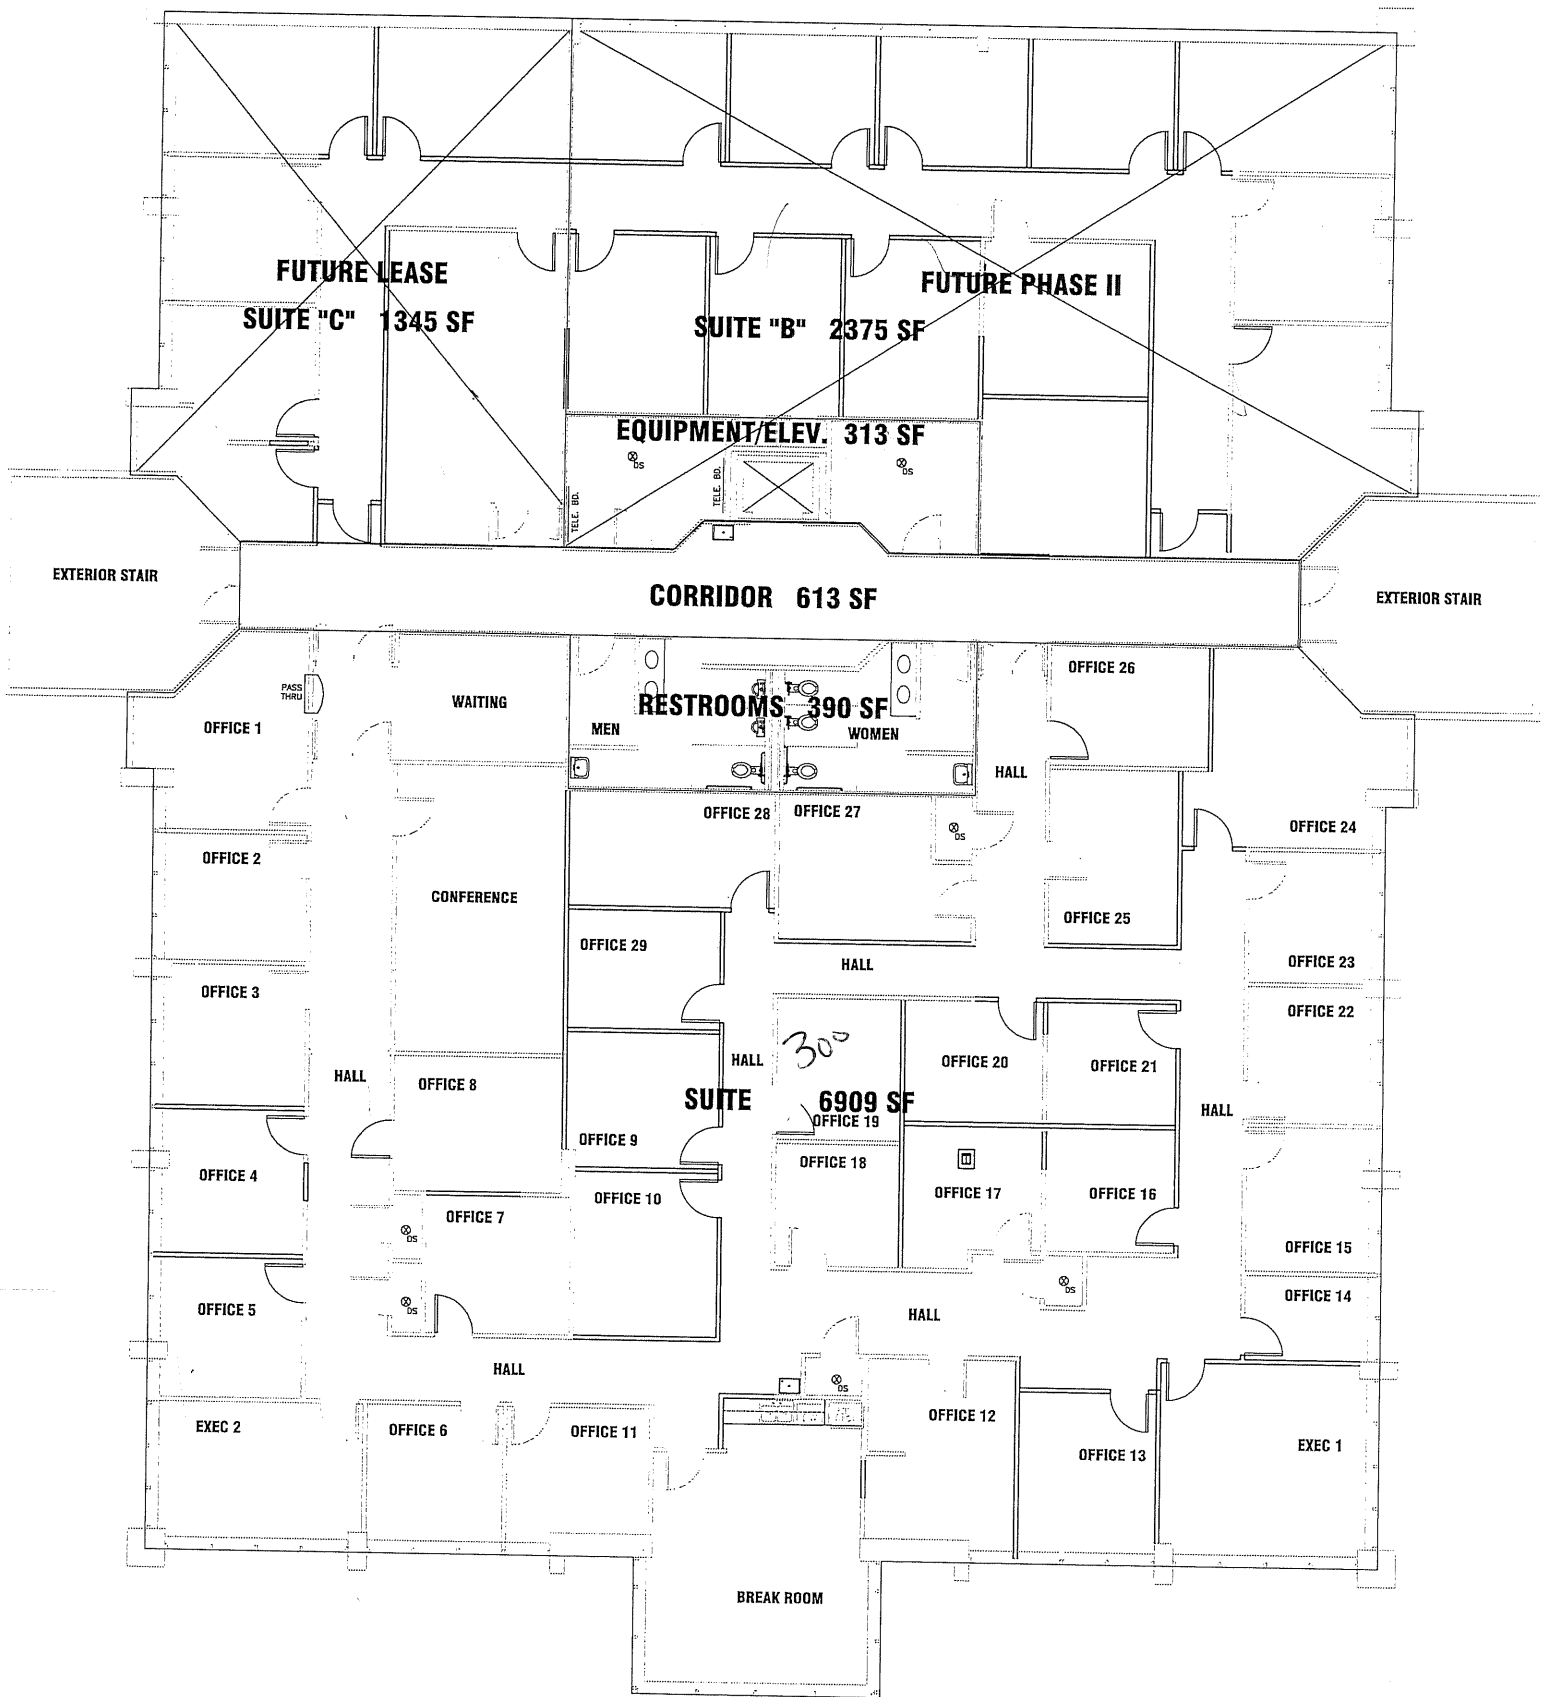


EXHIBIT "A"
THIRD FLOOR