


**BOSWELL WEST  
MEDICAL OFFICE  
BUILDING**

**Floor 03**

Suite 310  
AS-BUILT

857 SF  
AVAILABLE

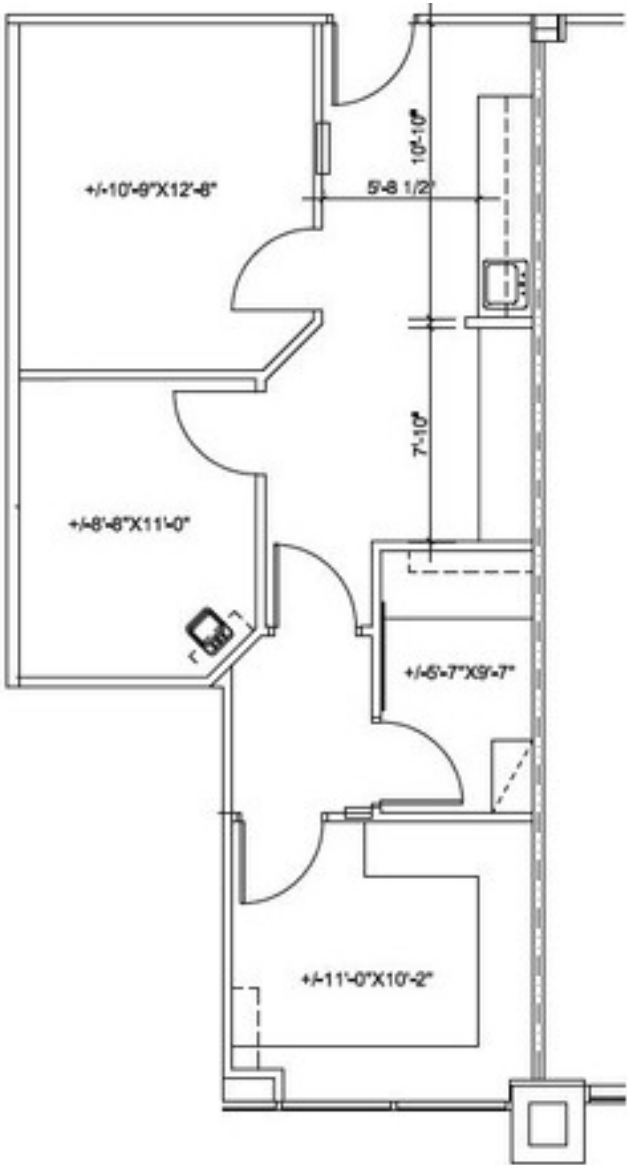

**RACHAEL THOMPSON**  
Senior Vice President  
602.513.5122  
rachael.thompson@kidder.com

**PERRY GABUZZI, CCIM**  
Senior Vice President  
602.513.5116  
perry.gabuzzi@kidder.com