

REVISIONS	NO.	DATE

COPYRIGHT  
 THIS DRAWING AND ALL REPRODUCTIONS ARE THE PROPERTY OF ALL ARCHITECTURE, LLC AND MAY NOT BE USED IN ANY WAY WITHOUT THEIR PERMISSION.

**PROJECT TITLE:**  
 5955 SHILOH ROAD E  
 AS-BUILTS  
 5955 SHILOH RD E  
 SUITES 90, 110 & 120  
 ALPHARETTA, GEORGIA 30005

**SEAL:**  
 PRELIMINARY

**DRAWN:** JCA  
**CHECKED:** JCA  
**APPROVED:** JCA  
**ISSUE DATE:** 02/15/26

**CAD FILE NAME:** 26007.dwg

**SHEET TITLE:**  
 AS-BUILT FLOOR PLAN - SUITE 120


**PROJECT NUMBER:** 26007

**SHEET NO.:**

**A2.2**

5955 SHILOH RD E - 1ST FLOOR

NOT ISSUED FOR CONSTRUCTION

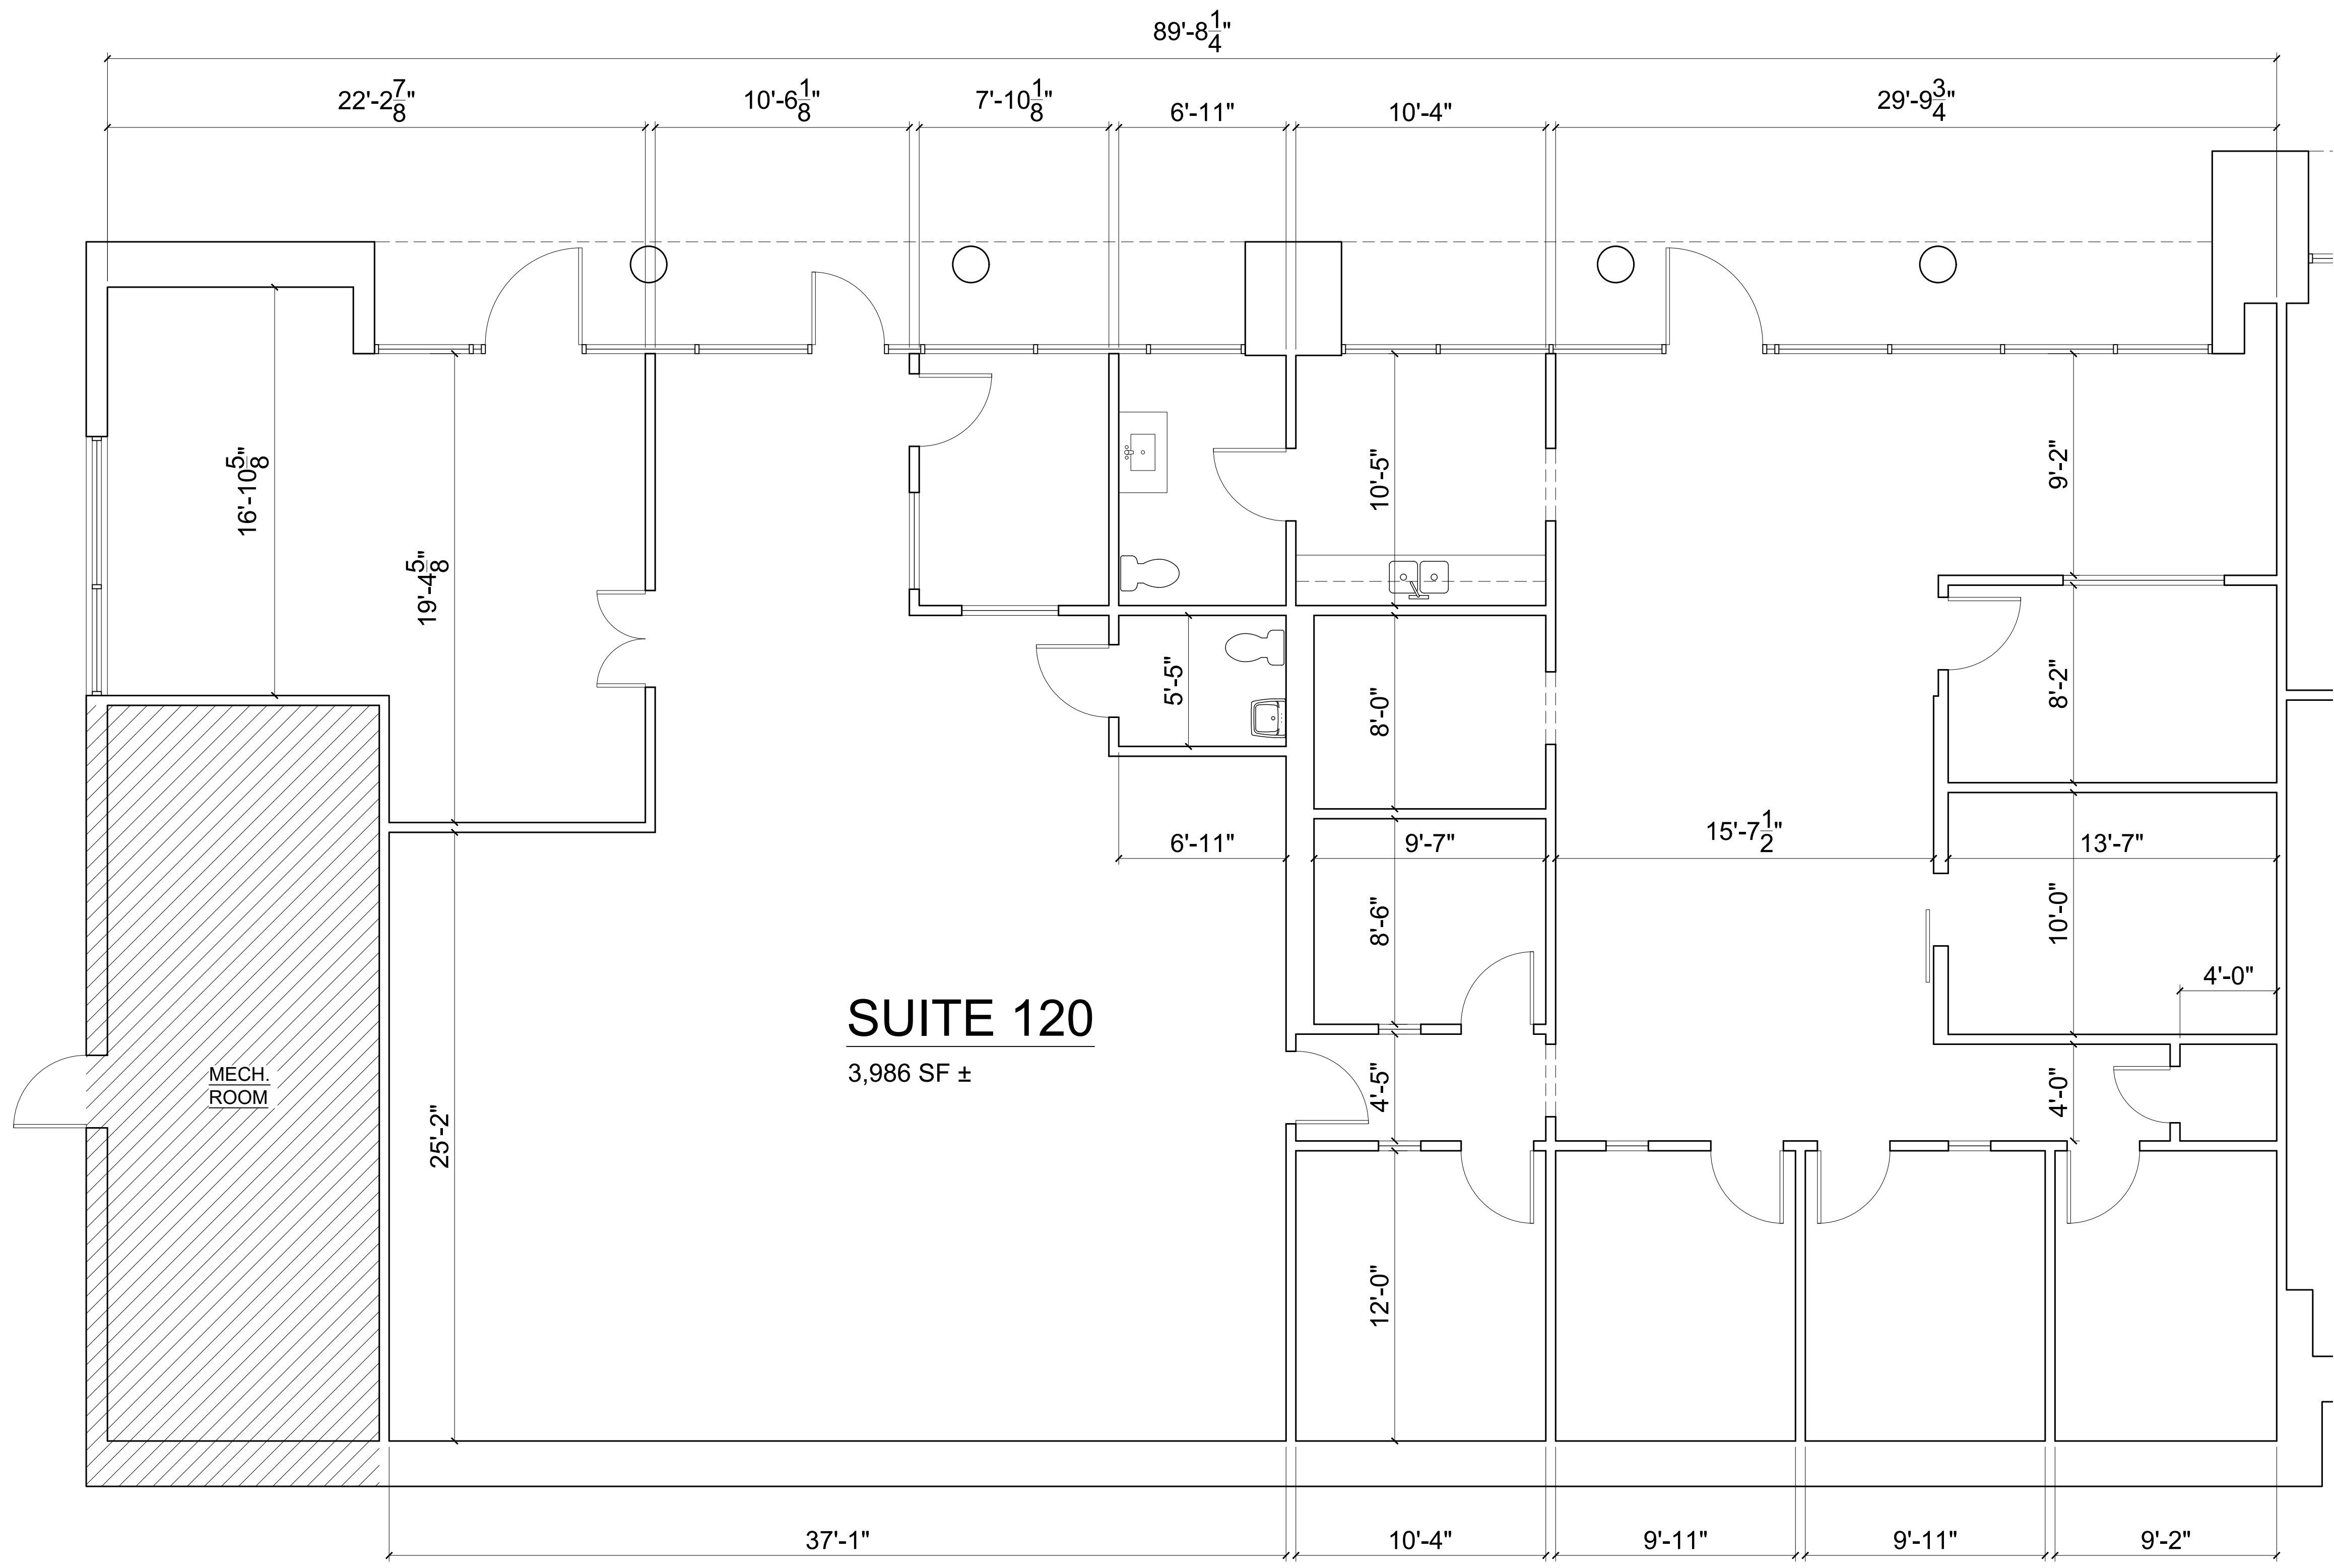

**SUITE 120**  
 3,986 SF ±

**AS-BUILT FLOOR PLAN - SUITE 120**  
 SCALE: 1/4" = 1'-0"  
 0 2 4 8

