


NORTH  
A1  
D101  
EXISTING FLOOR PLAN  
SCALE: 1/4" = 1'-0"

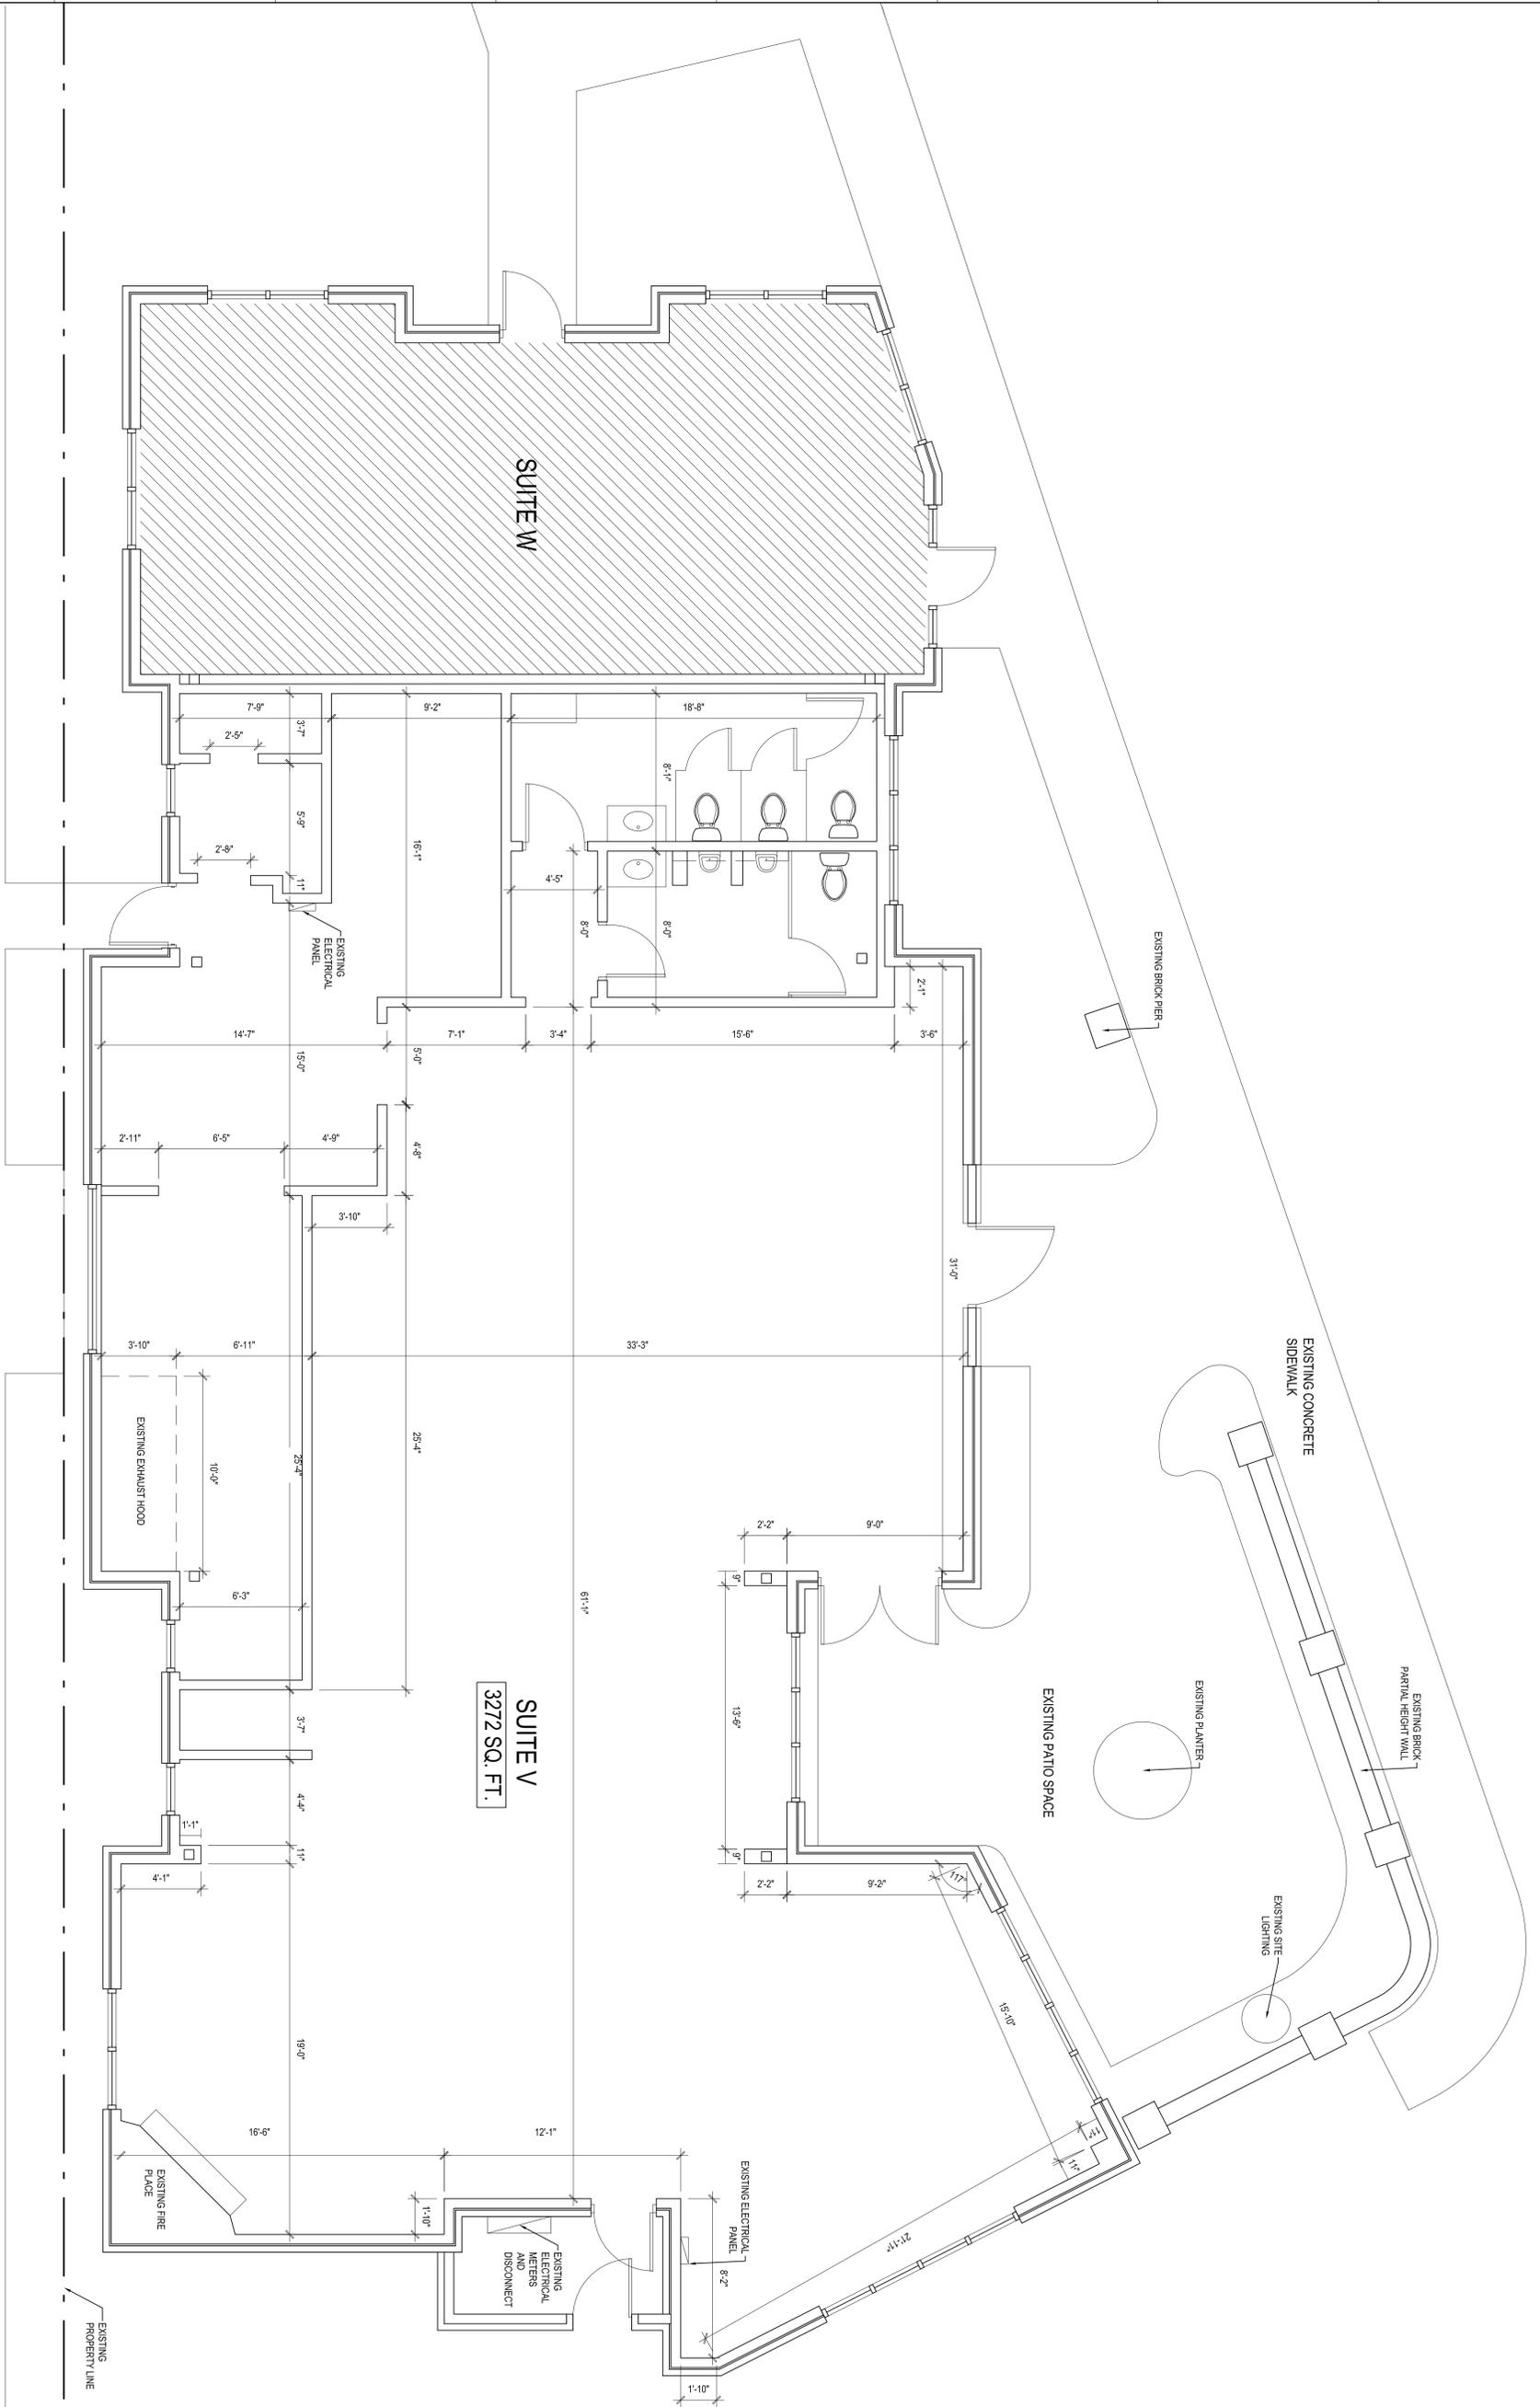

SUITE V  
3272 SQ. FT.

EXISTING SIDEWALK

MAYBANK HWY

CONCEPTUAL DESIGN

A101

EXISTING FLOOR PLAN

COAST PROJECT NO.: 1907.00

DATE: 08.16.2019  
CHECKED BY: FMM  
DRAWN BY: LMM

REVISIONS:  
△ △ △

**JAMES ISLAND CENTER**  
CONCEPTUAL DESIGN  
1739 MAYBANK HIGHWAY  
CHARLESTON, SOUTH CAROLINA

08.16.2019  
THIS SIGNED SEAL IS VALID ONLY FOR COAST PROJECT NO. 1907.00

**coast**  
architects  
671 St. Andrews Blvd., Charleston, SC 29407  
Phone: 843.763.7064 Fax: 843.763.7061  
www.coastarchitects.net