



01 BASEMENT PLAN
SCALE 1/8" = 1'

TOTAL BASEMENT AREA : 8,180 SQ. FT.
COMMON AREA DEVOTED BY CROSS HATCH: 6,791 SQ. FT. ———
BASEMENT CONFERENCE / OFFICE AREA: 1,437 SQ. FT. ———

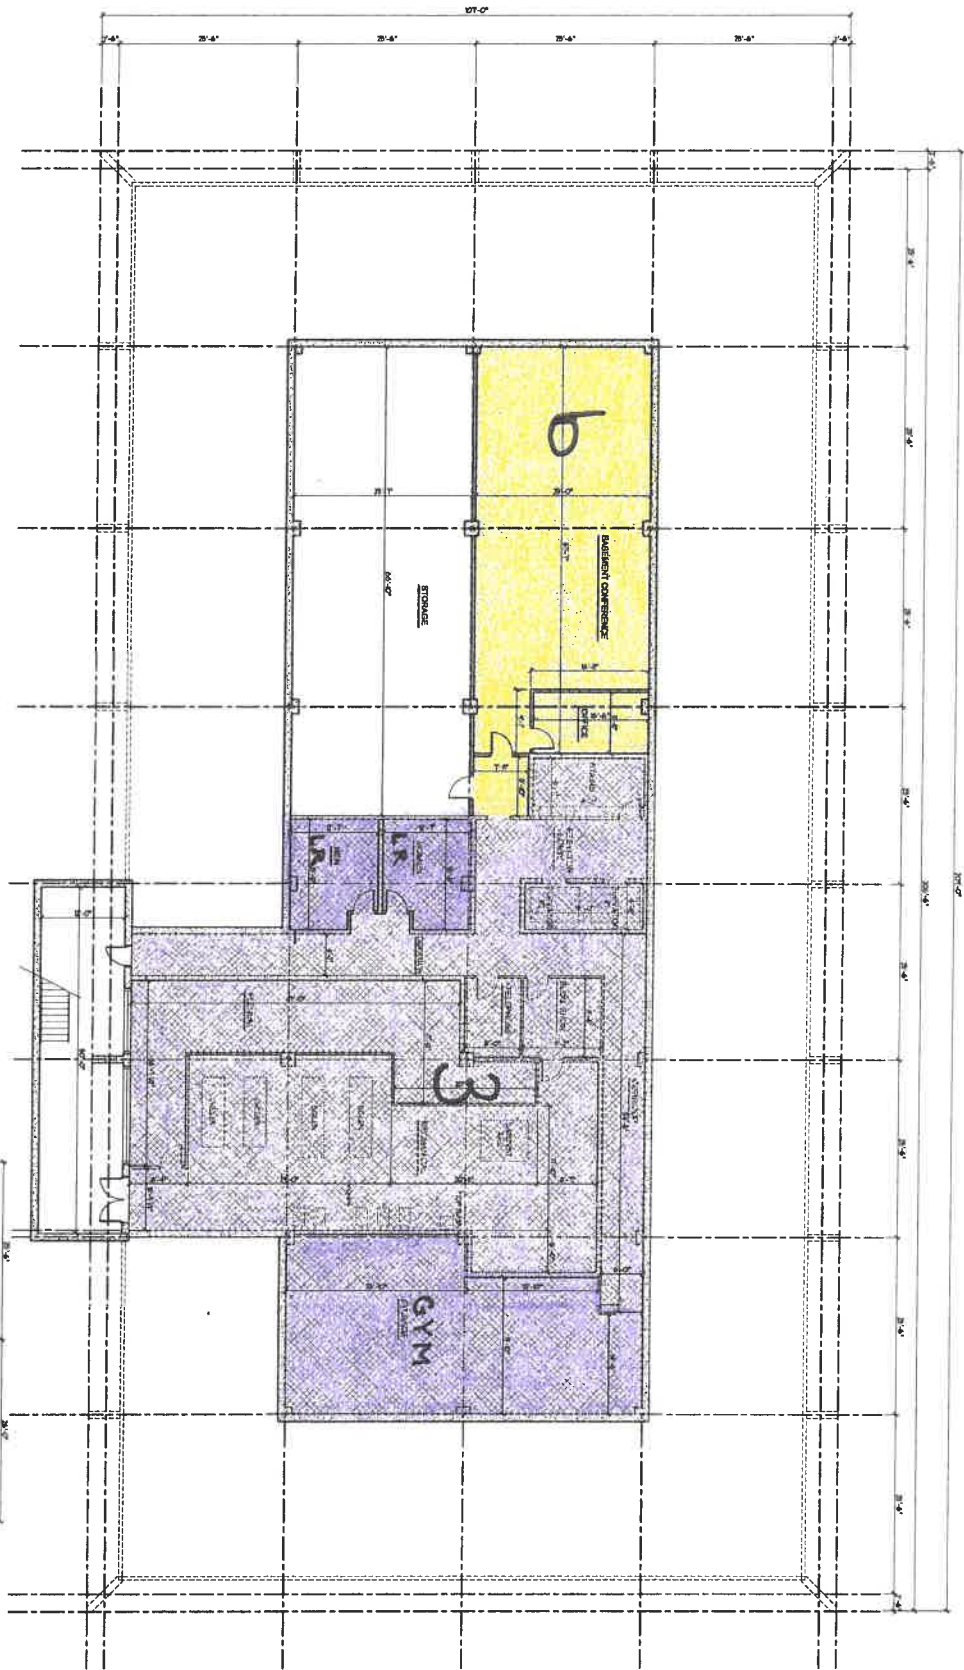

01 PENTHOUSE PLAN
SCALE 1/8" = 1'

TOTAL PENTHOUSE AREA : 1,826 SQ. FT.

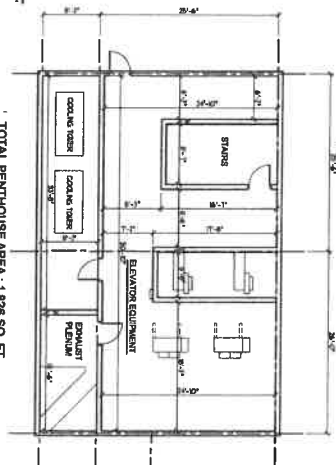

AS-BUILT - 05.13.15

A1

REVISIONS

NO.	DATE	DESCRIPTION
1	05.13.15	AS-BUILT

NOTES

- ALL WORK SHALL BE IN ACCORDANCE WITH THE LATEST EDITIONS OF THE INTERNATIONAL BUILDING CODES AND ALL APPLICABLE LOCAL ORDINANCES.
- ALL WORK SHALL BE IN ACCORDANCE WITH THE LATEST EDITIONS OF THE INTERNATIONAL BUILDING CODES AND ALL APPLICABLE LOCAL ORDINANCES.
- ALL WORK SHALL BE IN ACCORDANCE WITH THE LATEST EDITIONS OF THE INTERNATIONAL BUILDING CODES AND ALL APPLICABLE LOCAL ORDINANCES.

DESIGNED BY
VICTOR J. PATINO, NCARB
200 N. TOLSON AVE., 8TH FLOOR
DALLAS, TEXAS 75201
PH: 214-495-0443
vjp@victorjpatino.com

DATE
05.13.15

VICTOR J. PATINO, NCARB

200 N. TOLSON AVE., 8TH FLOOR
DALLAS, TEXAS 75201
PH: 214-495-0443
vjp@victorjpatino.com

HILLIARD
ENERGY

Marathon Building
125 West Missouri, Midland TX