


1 **Reduced As-built**
Suite 900

Scale: 1/8" = 1'-0"
North

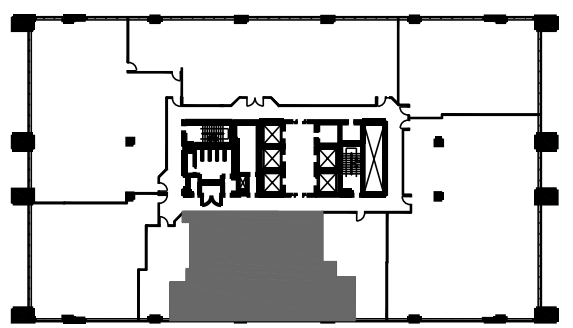

Proximity Plan

Suite 900
The Chancery
2,725 RSF