




1 FIRST FLOOR PLAN

SCALE: 1" = 20'-0"

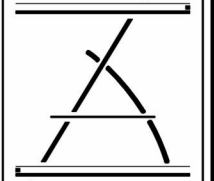

ZILER ARCHITECTS
 A PROFESSIONAL ARCHITECTURAL CORPORATION
 JAMES O. ZILER, ARCHITECT
 SEAN R. PRIMEAUX, ARCHITECT
 101 Calco Boulevard
 Lafayette, Louisiana 70503
 Ph: 337-269-6326
 10610 Florida Boulevard
 Walker, Louisiana 70785
 Ph: 225-424-6990
 www.zilerarchitects.net

DOCUMENTS PREPARED BY ZILER ARCHITECTS ARE INSTRUMENTS OF THE ARCHITECT'S SERVICE FOR USE SOLELY WITH RESPECT TO THIS PROJECT. THE ARCHITECT SHALL RETAIN ALL COMMON LAW, STATUTORY AND OTHER RESERVED RIGHTS, INCLUDING THE COPYRIGHT. THEY ARE NOT TO BE USED BY THE CONTRACTOR OR ANY SUBCONTRACTOR, MATERIAL OR EQUIPMENT SUPPLIERS OR ANYONE FOR OTHER PROJECTS OR FOR ADDITIONS TO THIS PROJECT OUTSIDE THE SCOPE OF THE WORK WITHOUT THE SPECIFIC WRITTEN CONSENT OF ZILER ARCHITECTS.


RECORD DRAWINGS FOR:
315 SOUTH COLLEGE BUILDING
 315 SOUTH COLLEGE ROAD
 LAFAYETTE, LOUISIANA 70503



DATE ISSUED	05/12/23
REVISED	-
PLOT DATE	06/29/23 4:00:18 PM
DRAWN BY	SRP
CHECKED BY	JOZ
PROJECT NO.	2309
SHEET NO.	A0.1
	OF 0



Suite 135

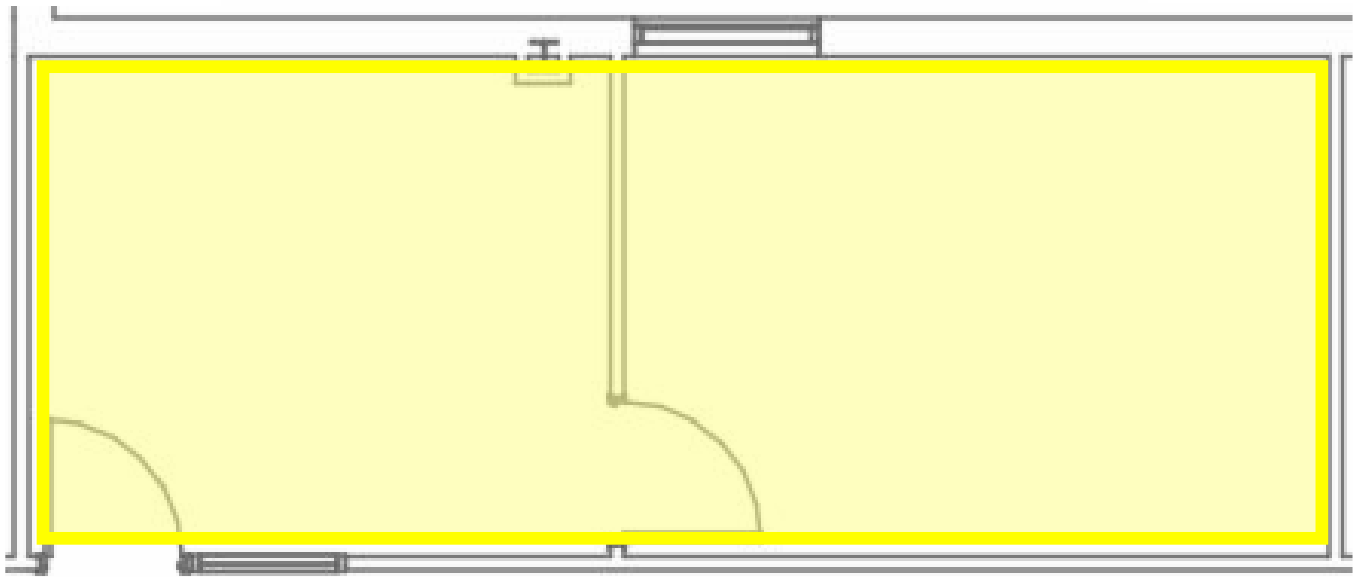

Suite 135
Rentable Sqft - 406 sqft