



② (E) 2ND. FLOOR PLAN UNIT 32  
1/4"=1'-0"

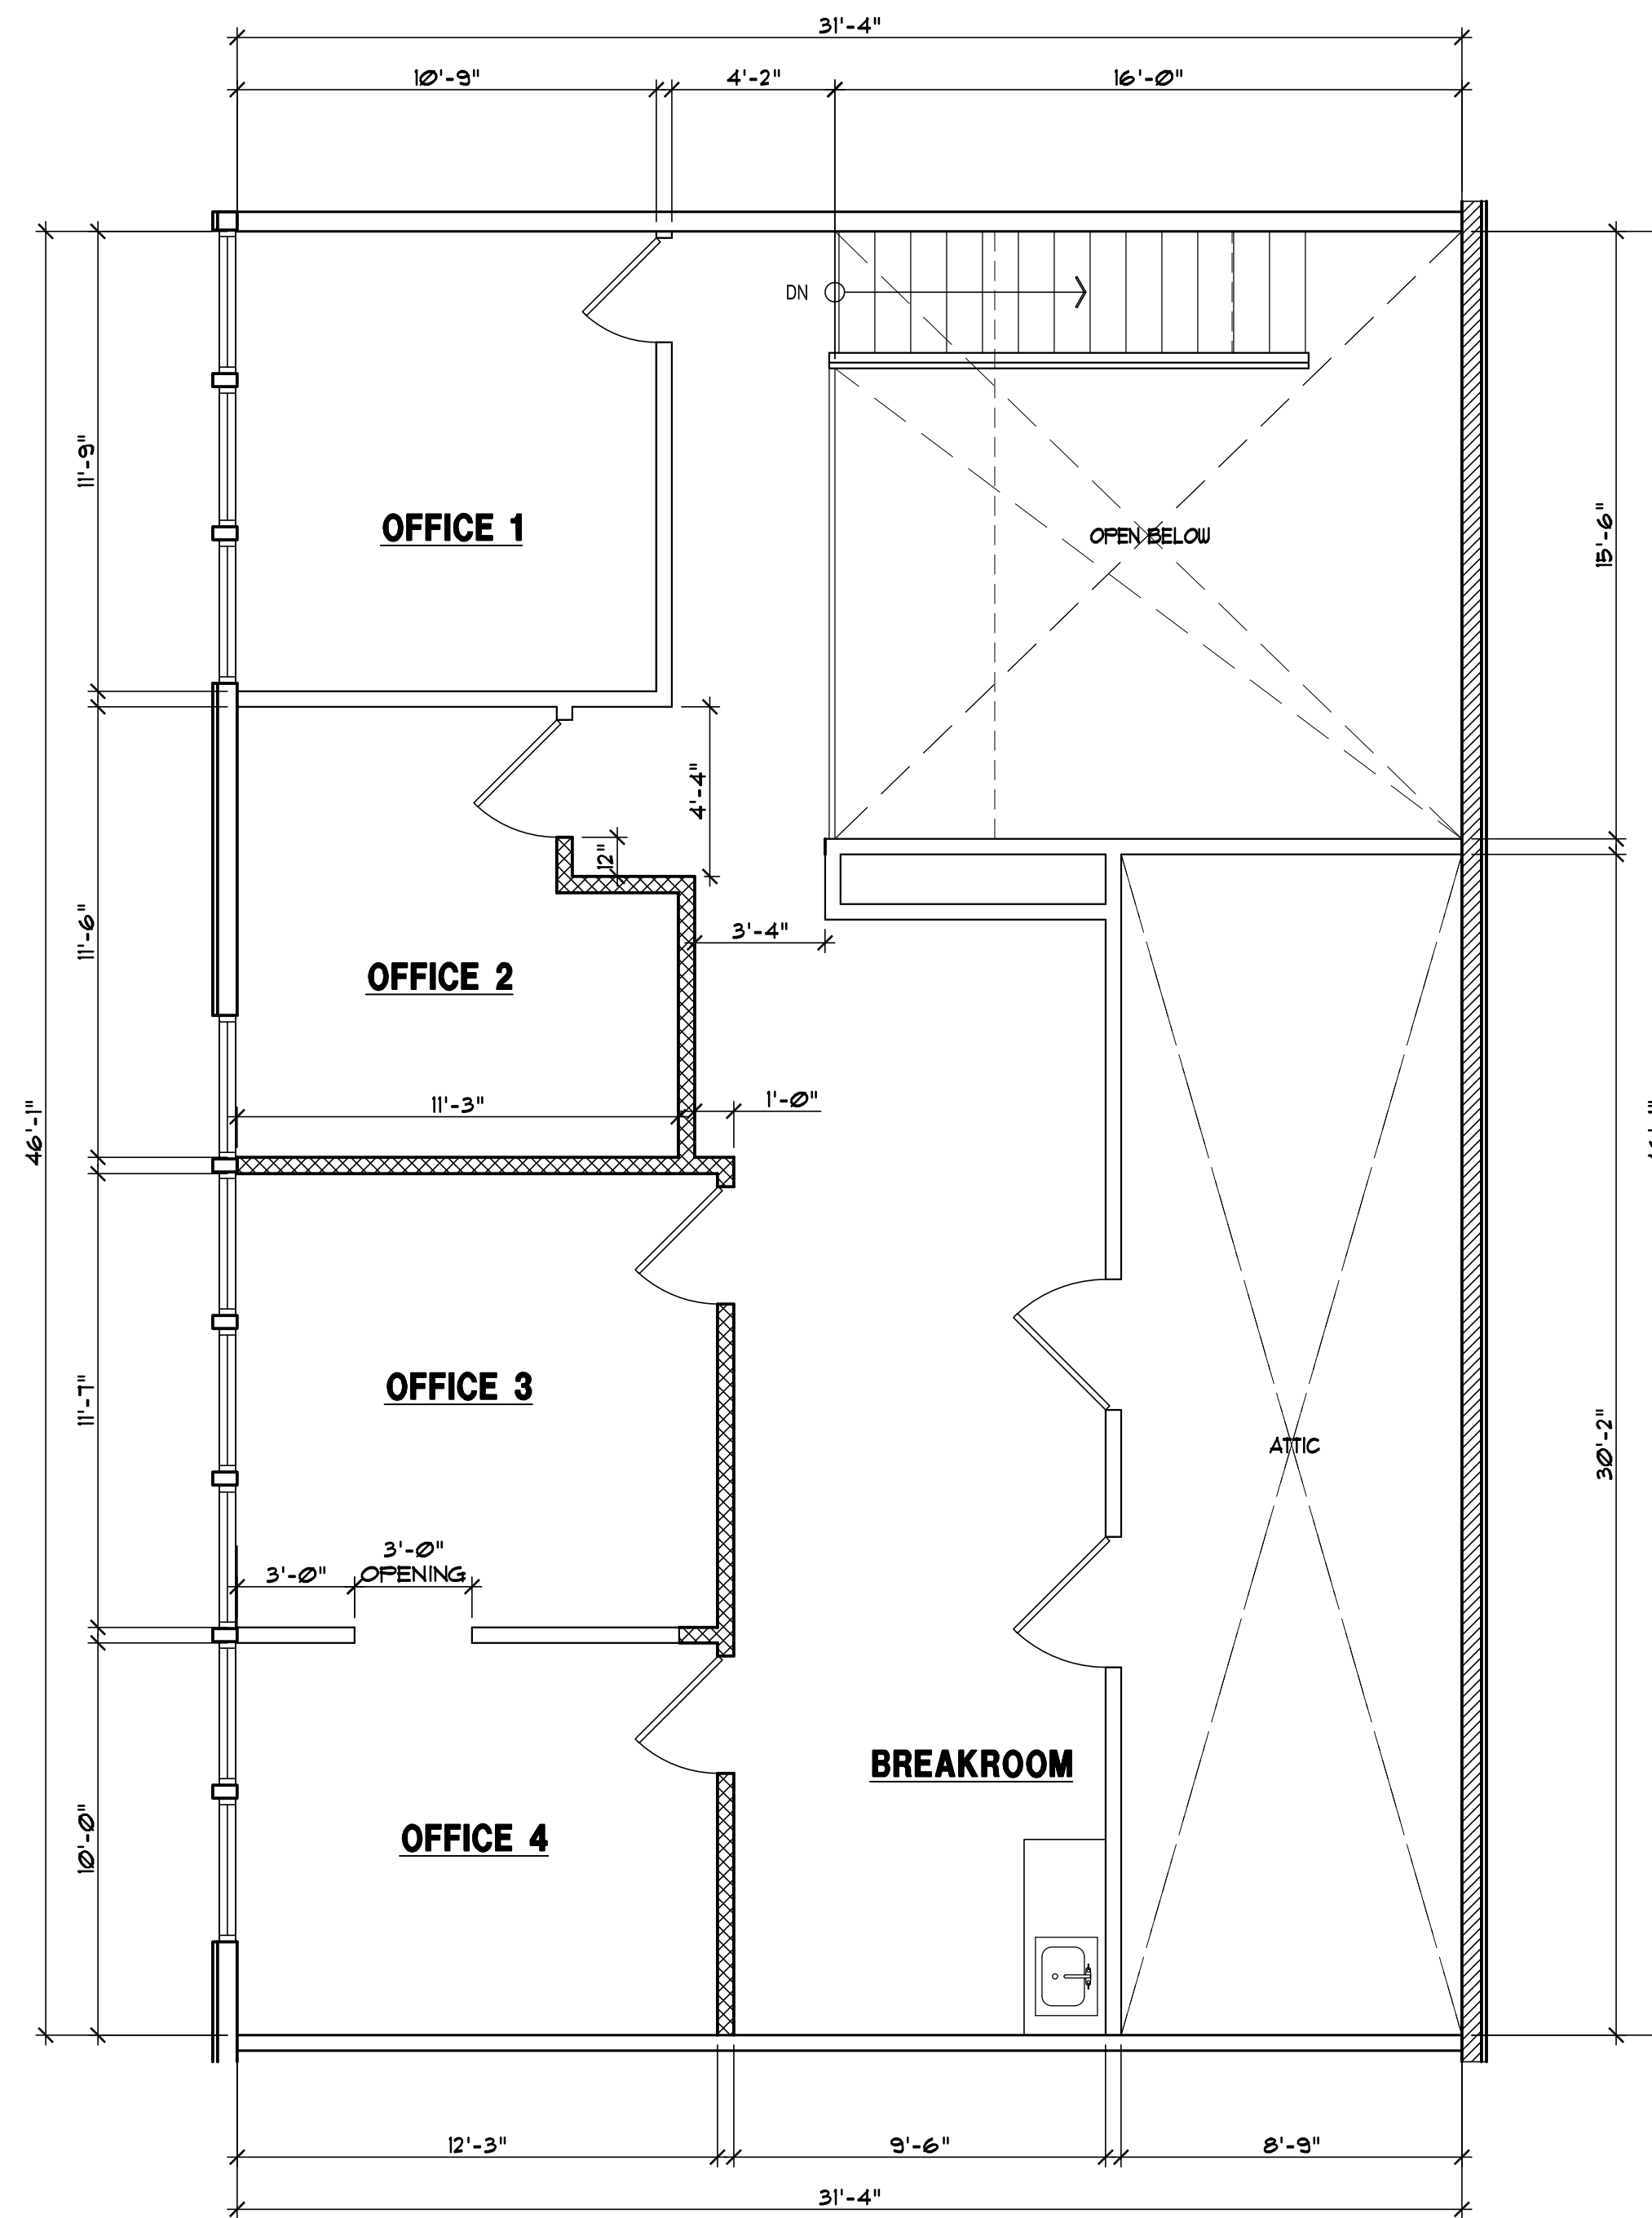

③ (N) 2ND. FLOOR PLAN UNIT 32  
1/4"=1'-0"

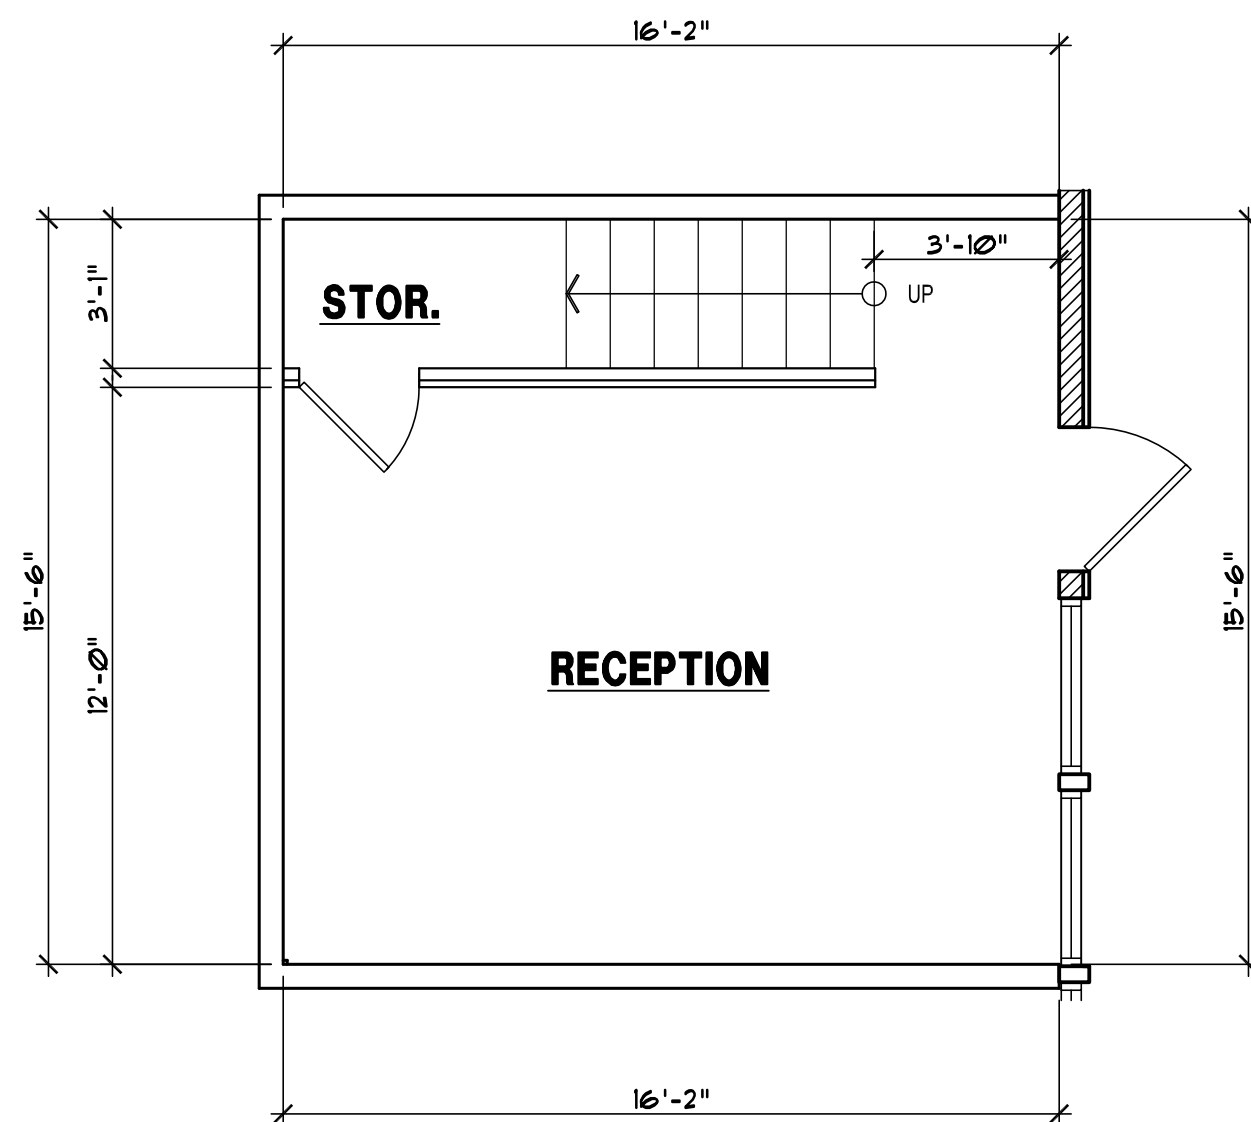

① (E) FIRST FLOOR PLAN UNIT 32  
1/4"=1'-0"

REVISIONS	BY

PROJECT ADDRESS

AS-BUILT SITE PLAN & FLOOR PLAN OF UNITS #5,  
#1, 29, 31, 32, 43, 46 & 47

CONTACT PERSON: XIMENA TIPAN PHONE 562-714-7146

2021 SPERRY AVENUE  
VENTURA, CA 93003

TITLE
EXISTING FLOOR PLAN UNITS 31 & 32
DATE 11-04-23
SCALE AS SHOWN
DRAWN AT
JOB 00
SHEET
<b>A-2.5</b>
SHEET OF