
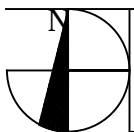


1522 West Todd Drive
Tempe . AZ
Suite C105 - 4,628 SF

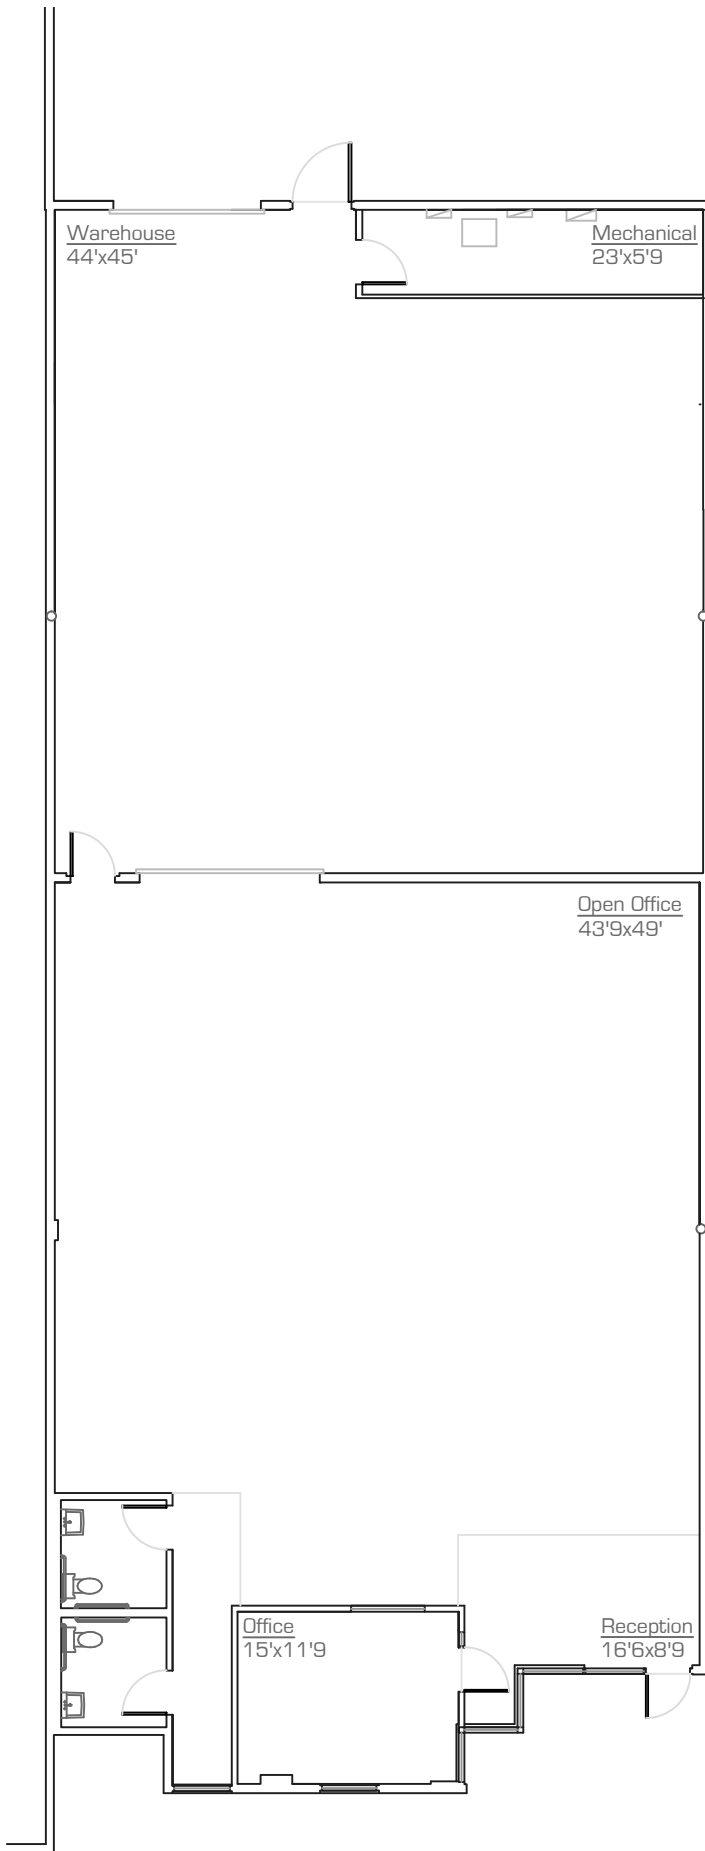

As-Built

scale: nts

28.January.2026

*All dimensions are approximate at $\pm 3"$

*All information is of general nature

precisionDIMENSIONS

as-built & survey
602.790.6412

