


**SEVENTH FLOOR**

132 EAST BROADWAY SUITE 716  
EUGENE, OREGON 97401

**SUITE 716  
AS-BUILT**

PROJECT #  
DRAWN WB  
CHECKED ALS  
DATE 03/09/16

SHEET  
**A2.0**

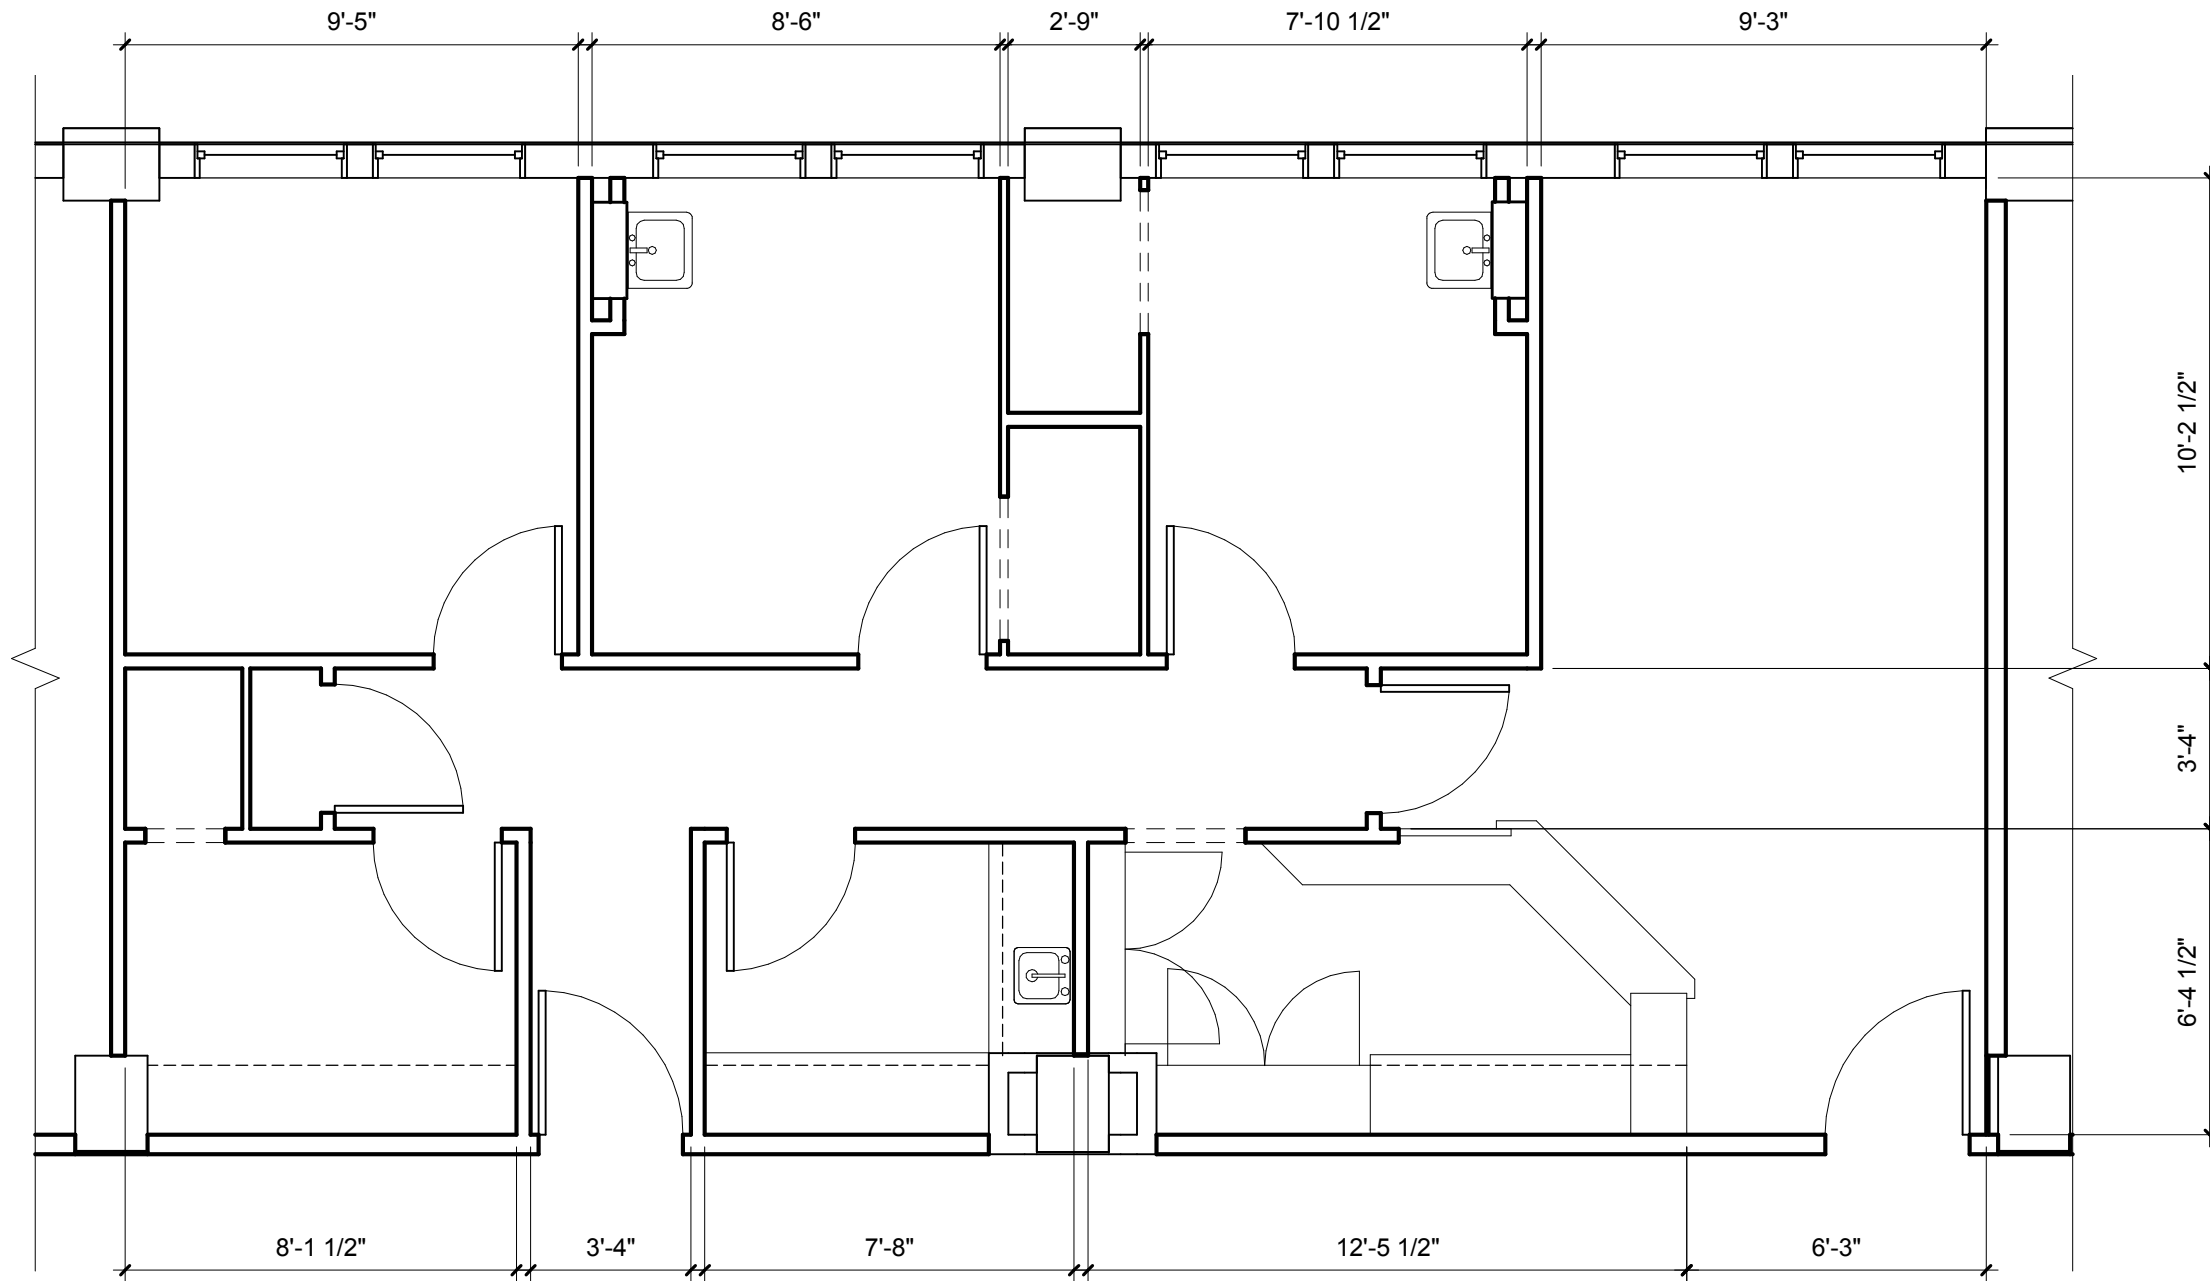

**1 SUITE 716 AS-BUILTS**  
A2.0 1/4" = 1'-0"