



9735 WILSHIRE BLVD.
BEVERLY HILLS, CA 90212

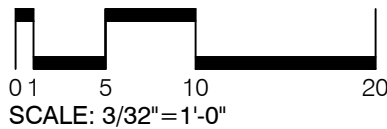

FLOOR LOCATION

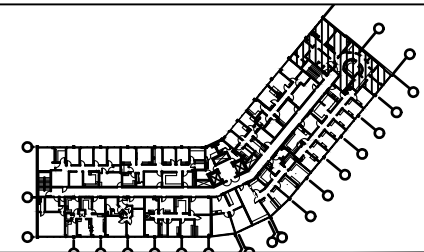

LAArchitects

2659 Townsgate Rd. | Suite 200
Westlake Village | CA | 91361
O: 310.860.6071 | www.la-archs.com

SUITE	400	RSF	1,758
FLOOR	4	DATE	12.22.23

