


FOR LEASE

Arrowhead Creekside

7200 WEST BELL ROAD | GLENDALE, AZ

Suites E-103 & E-104

AS BUILT

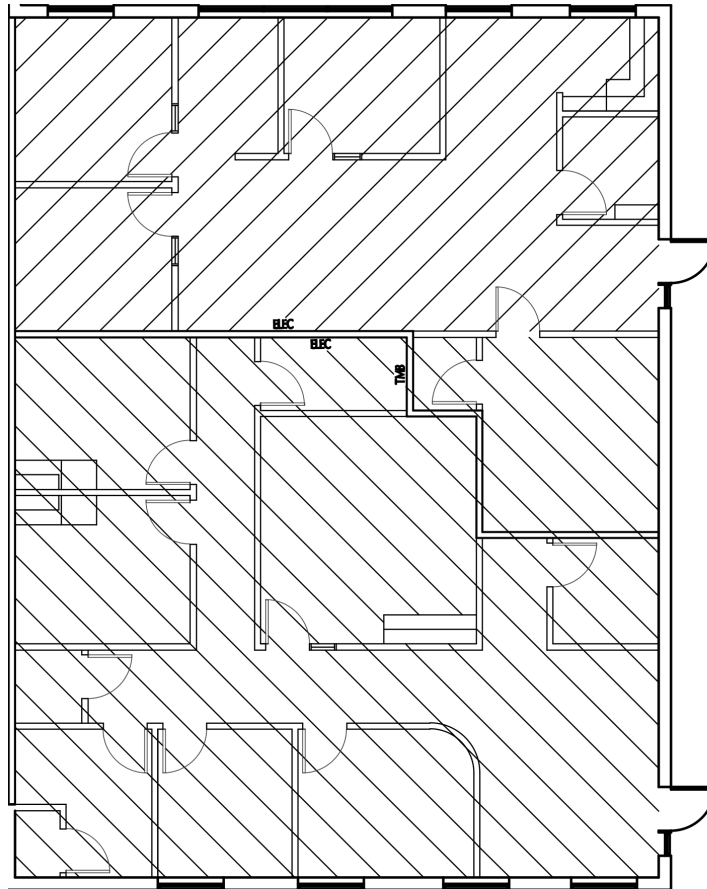

±3,071 SF

SQUARE FEET

\$25.00 NNN

LEASE RATE

RACHAEL THOMPSON

Senior Vice President

602.513.5122

rachael.thompson@kidder.com

PERRY GABUZZI, CCIM

Senior Vice President

602.513.5116

perry.gabuzzi@kidder.com

KIDDER.COM

This information supplied herein is from sources we deem reliable. It is provided without any representation, warranty, or guarantee, expressed or implied as to its accuracy. Prospective Buyer or Tenant should conduct an independent investigation and verification of all matters deemed to be material, including, but not limited to, statements of income and expenses. Consult your attorney, accountant, or other professional advisor.

