

REVISION	DATE	REVISION	DATE
CONSTRUCTION DOCUMENTS	08-26-04	STRUCTURAL REVISION	09-22-04
PLAN REVIEW RESPONSES	10-28-04		

STAFFORD JEWELRY - NEW FACILITY -
 2555 MIAMISBURG-CENTERVILLE RD
 DAYTON, OHIO 45459


PROJECT NAME & ADDRESS

PROJECT #

design build
 van con
 General Contractor
 8325 North Dixie Dr. - Dayton, Ohio 45424
 Phone (937) 890-8400



PROPOSED
 SITE PLAN & DETAILS

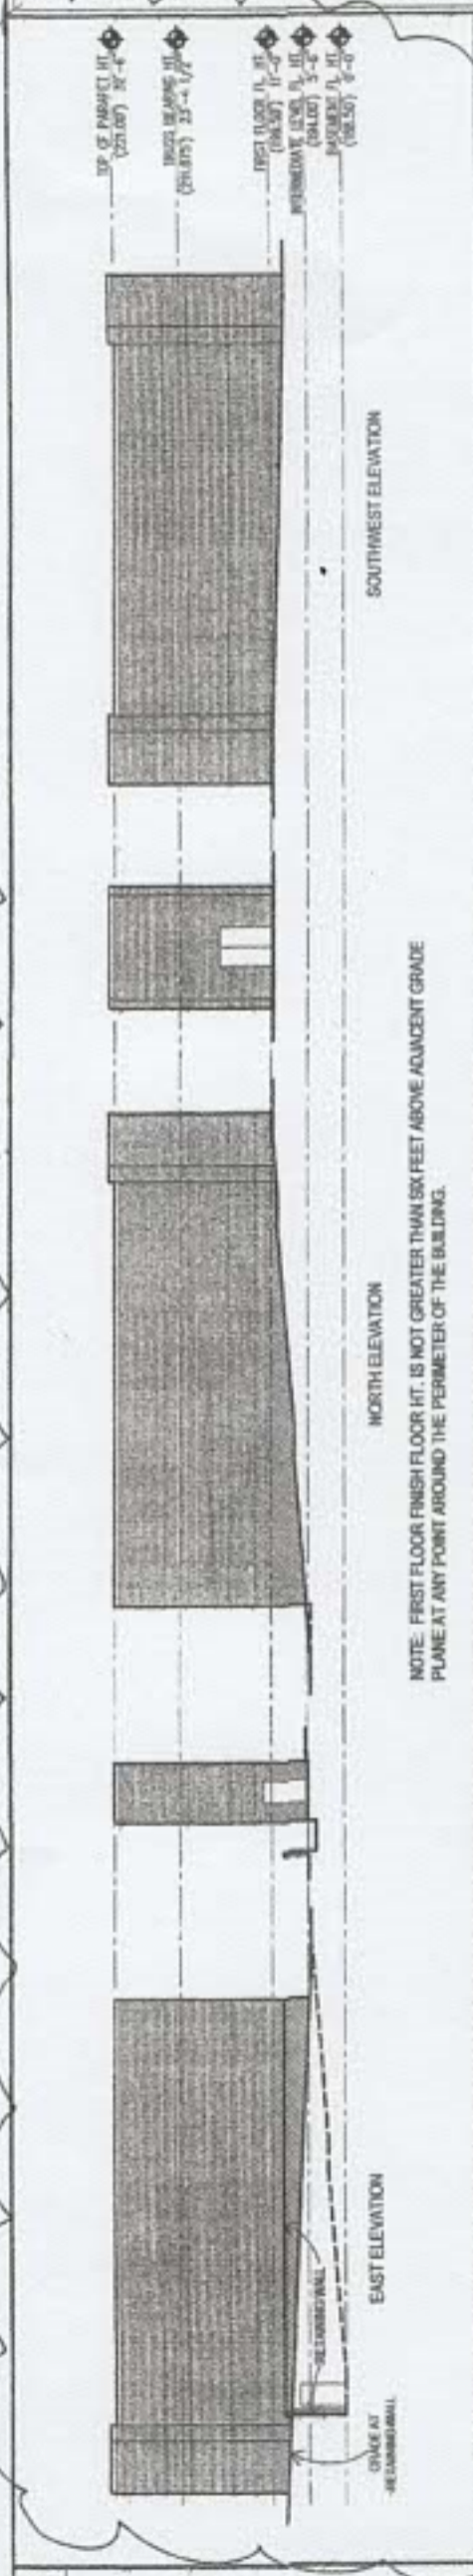

DIAGRAMMATICAL ELEVATIONS SHOWING RELATIONSHIP OF FIRST FLOOR FINISH FLOOR HT. TO ADJACENT GRADE PLANE
 1/16"=1'-0"

