

CENTRAL PHYSICIANS PLAZA


Floor 03

Suite 306

AS-BUILT

984 SF

AVAILABLE

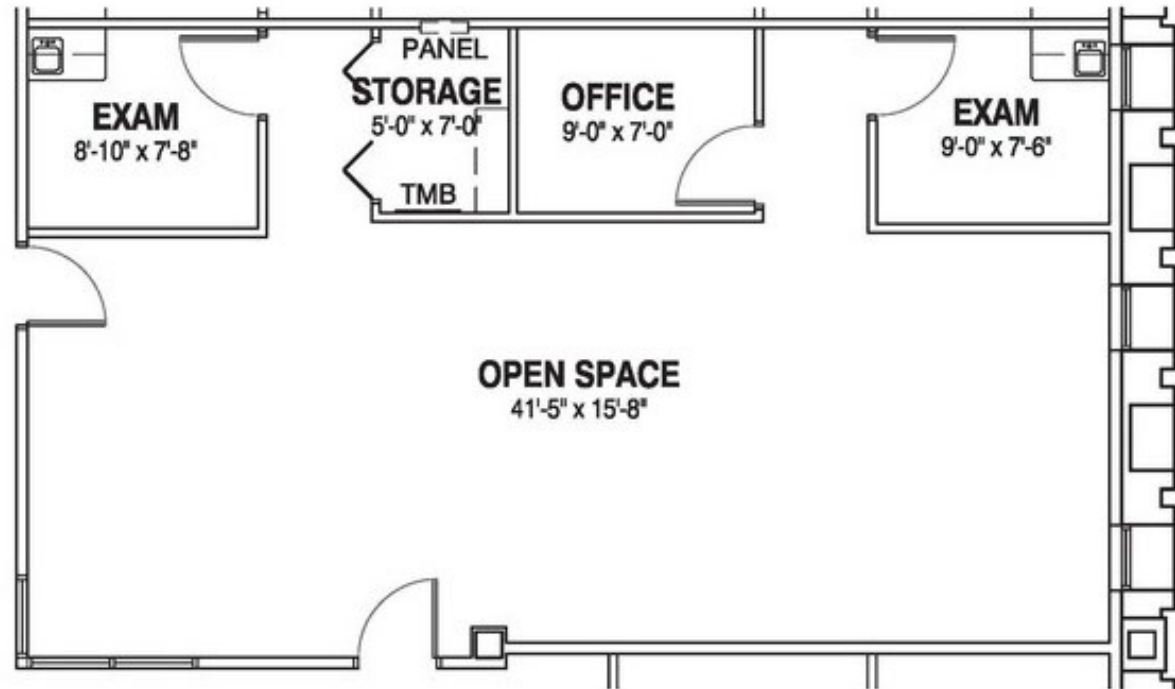

*CONTIGUOUS TO SUITE 306A AND 312 FOR 8,156 SF

RACHAEL THOMPSON
Senior Vice President
602.513.5122
rachael.thompson@kidder.com

PERRY GABUZZI, CCIM
Senior Vice President
602.513.5116
perry.gabuzzi@kidder.com



View Portfolio