
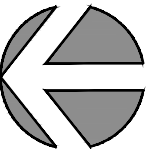


Pacific Avenue

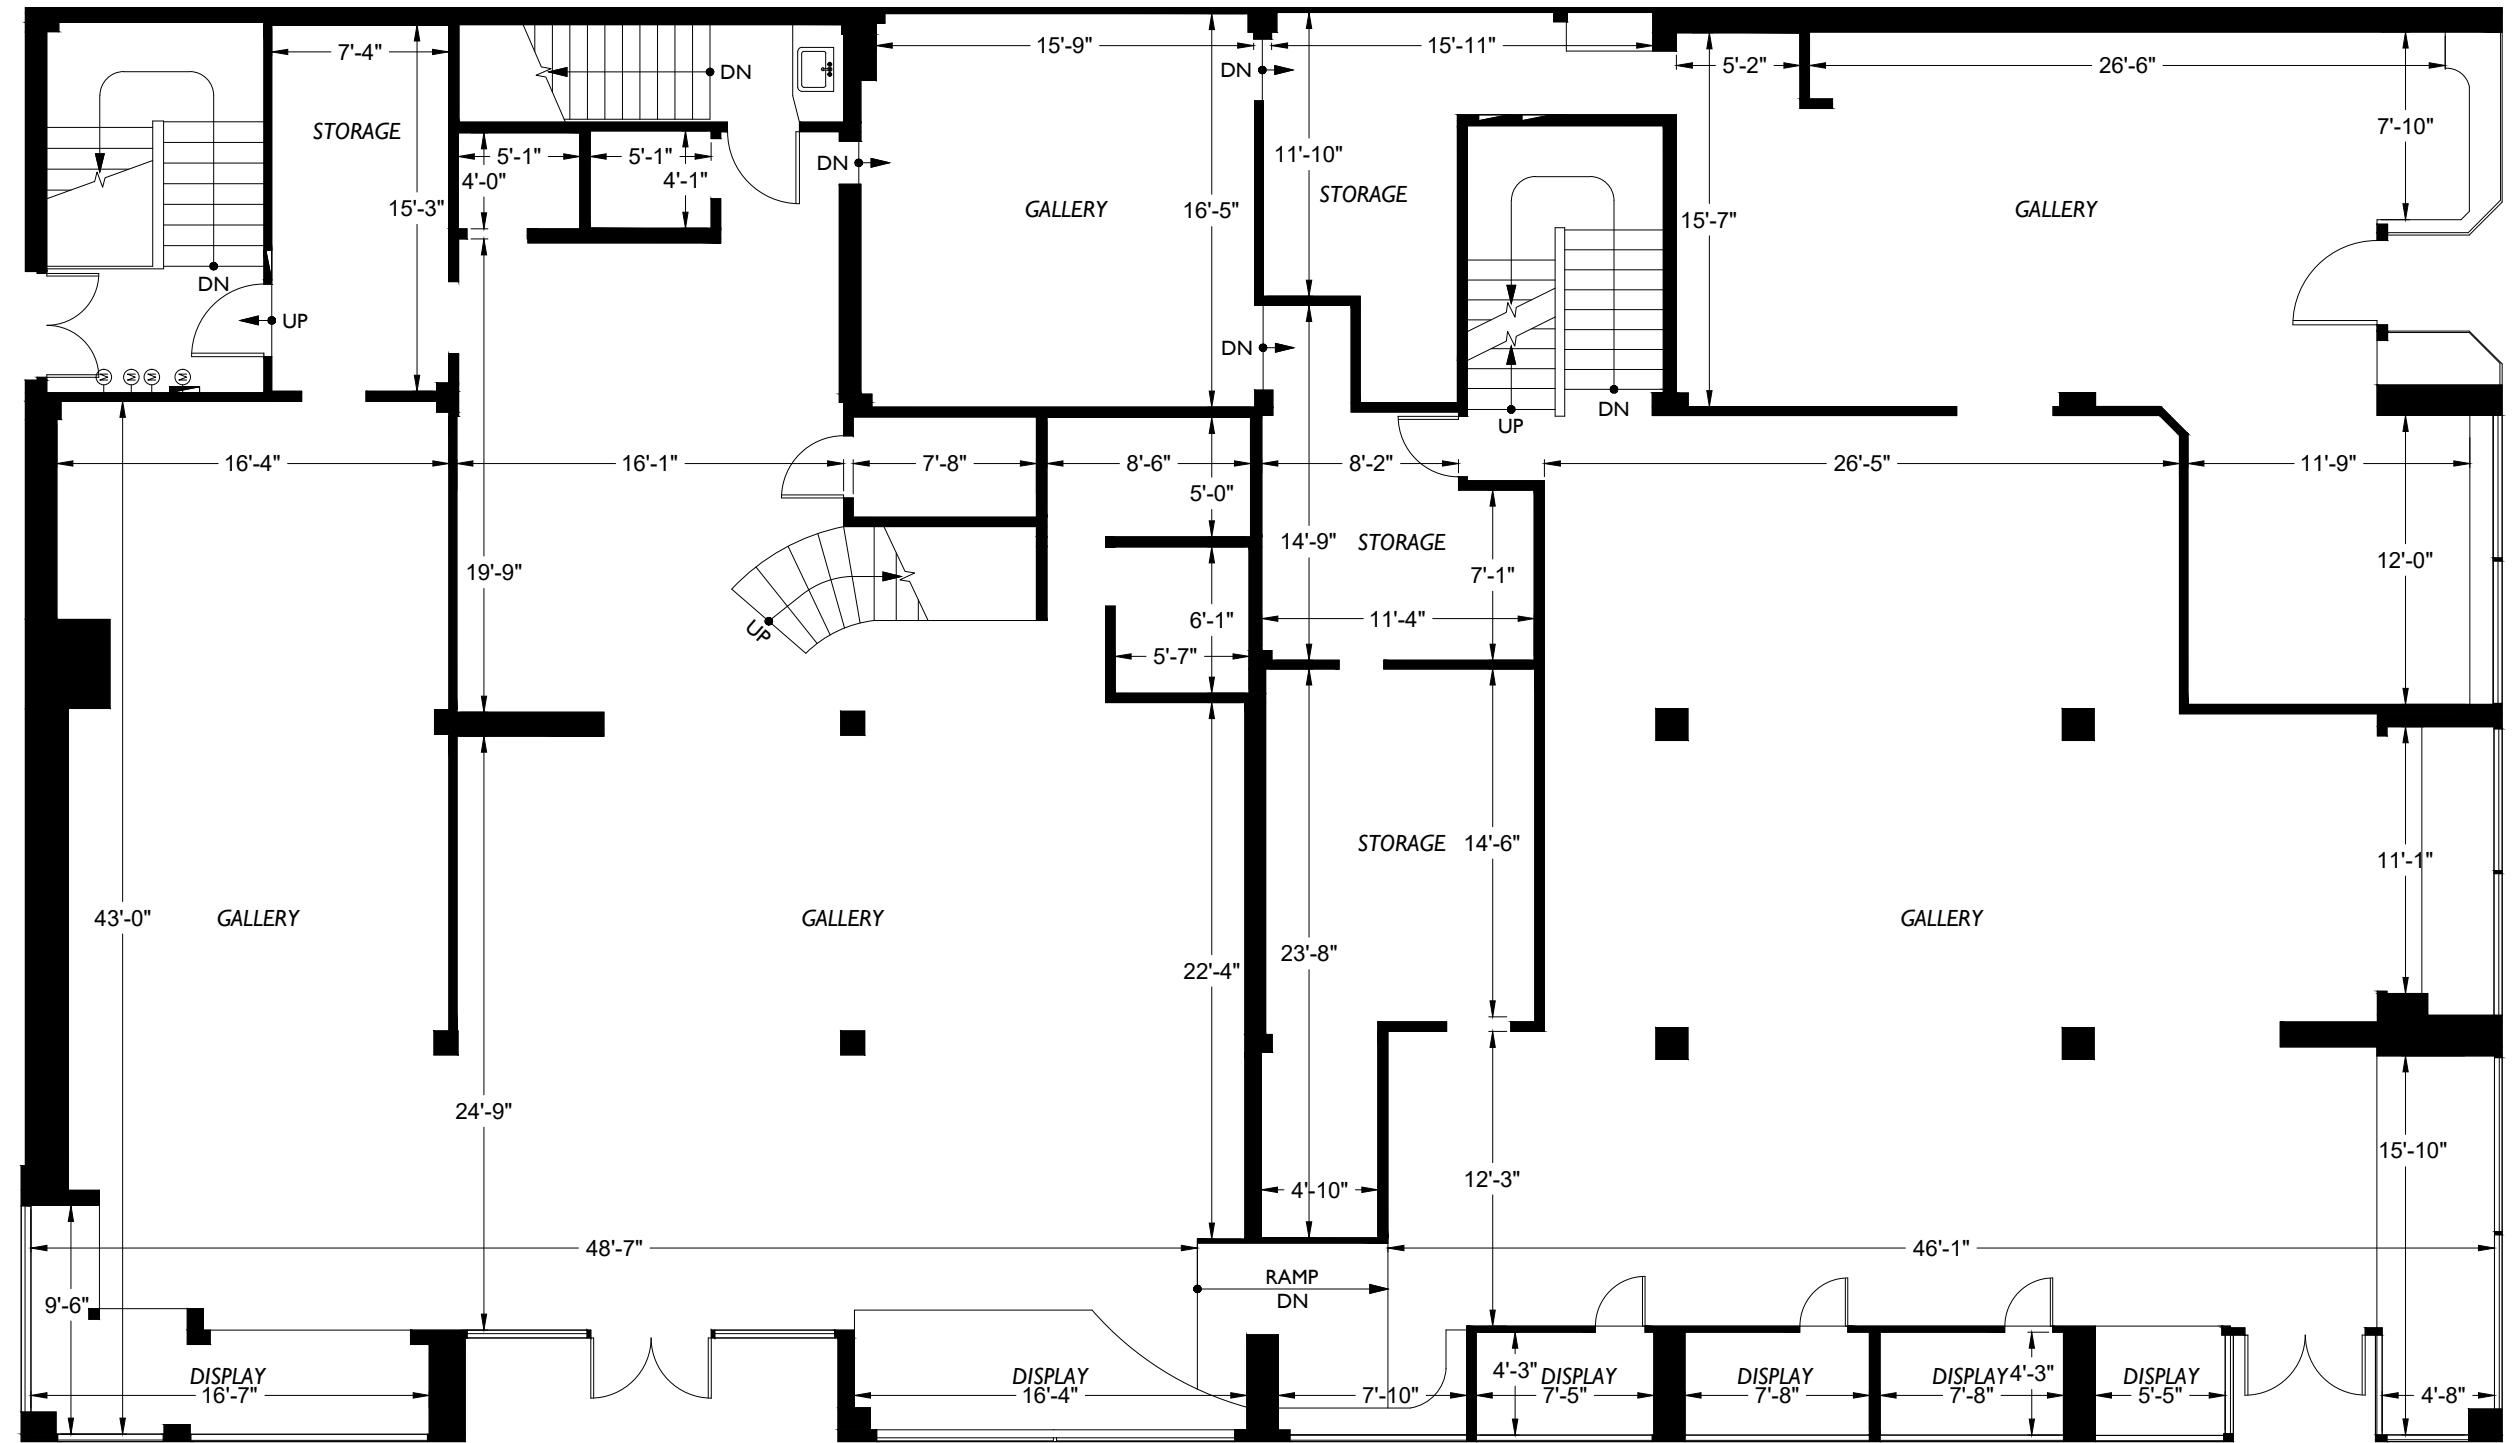


Floor Plan

Subject



Client


Scale


AS-BUILT
FLOOR PLANS
 2D-FLOORPLANS.COM
 425-677-7511
 600 NW Gilman Blvd. Suite E
 Issaquah, WA 98027
 Measured: December 2020 Project: C20-1134

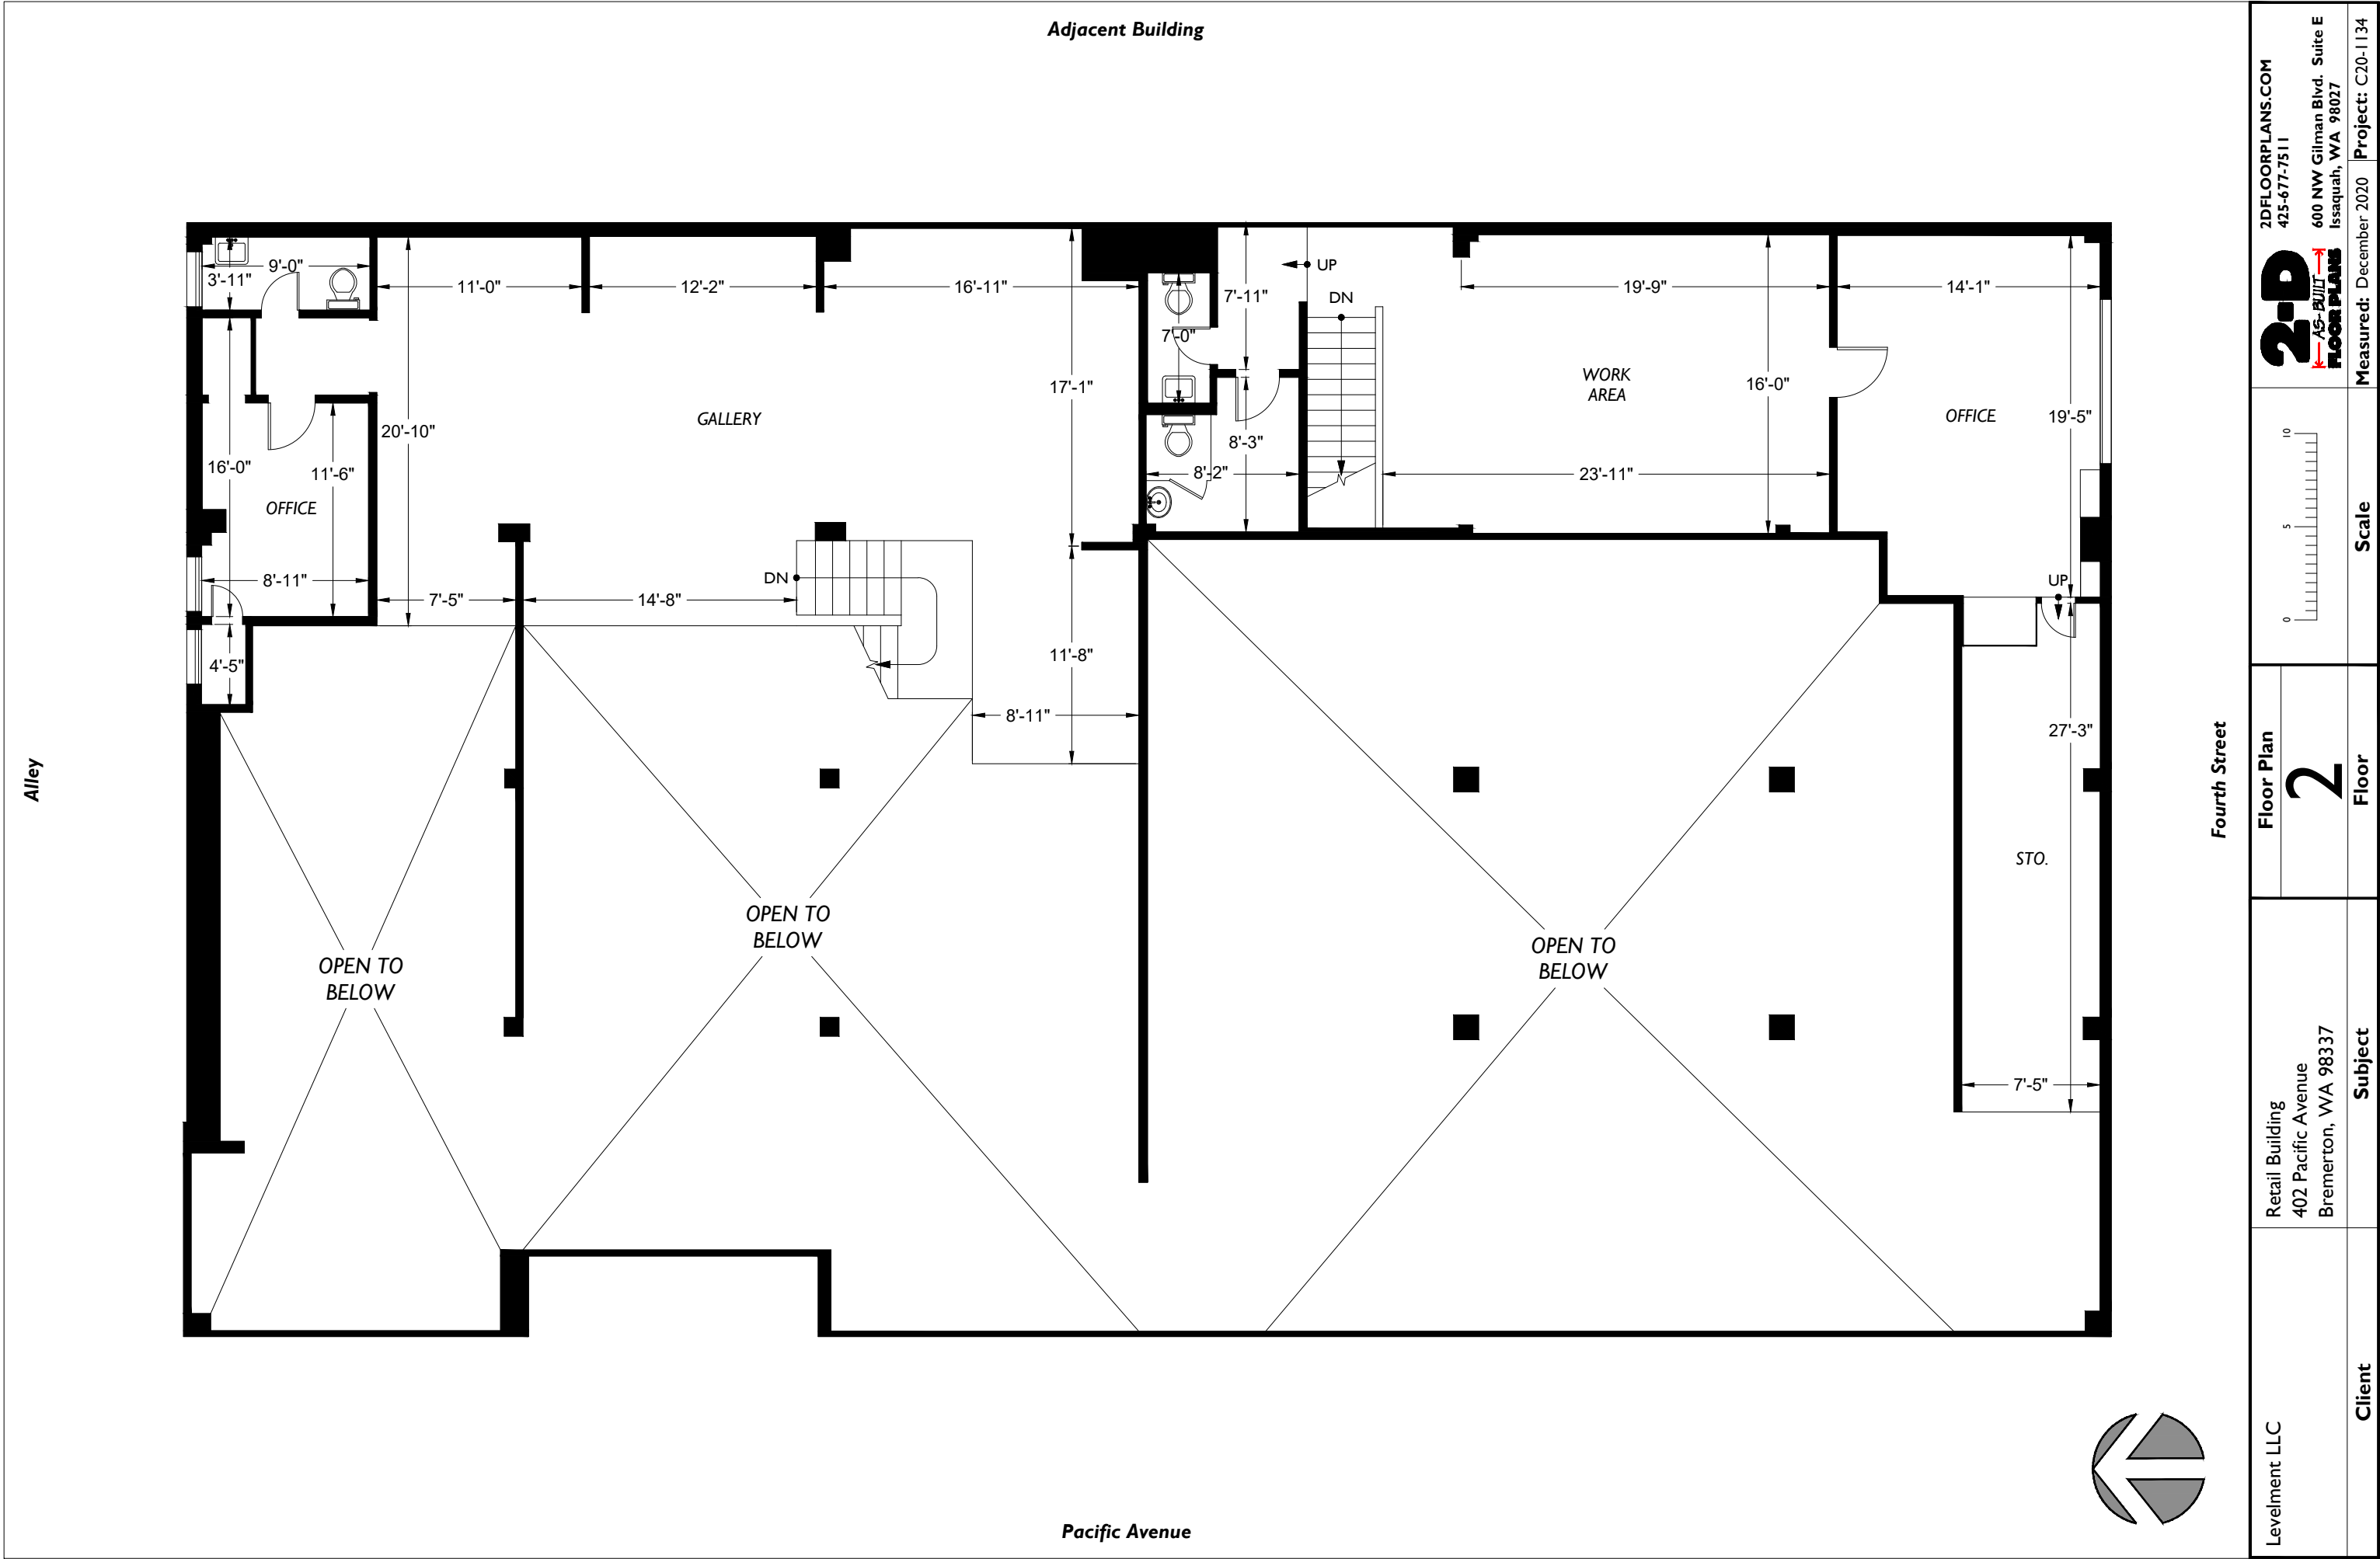

Levelment LLC	Retail Building 402 Pacific Avenue Bremerton, WA 98337	Floor Plan	2	Scale 	Measured: December 2020	Project: C20-1134
		Client				

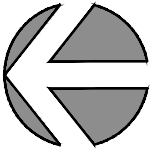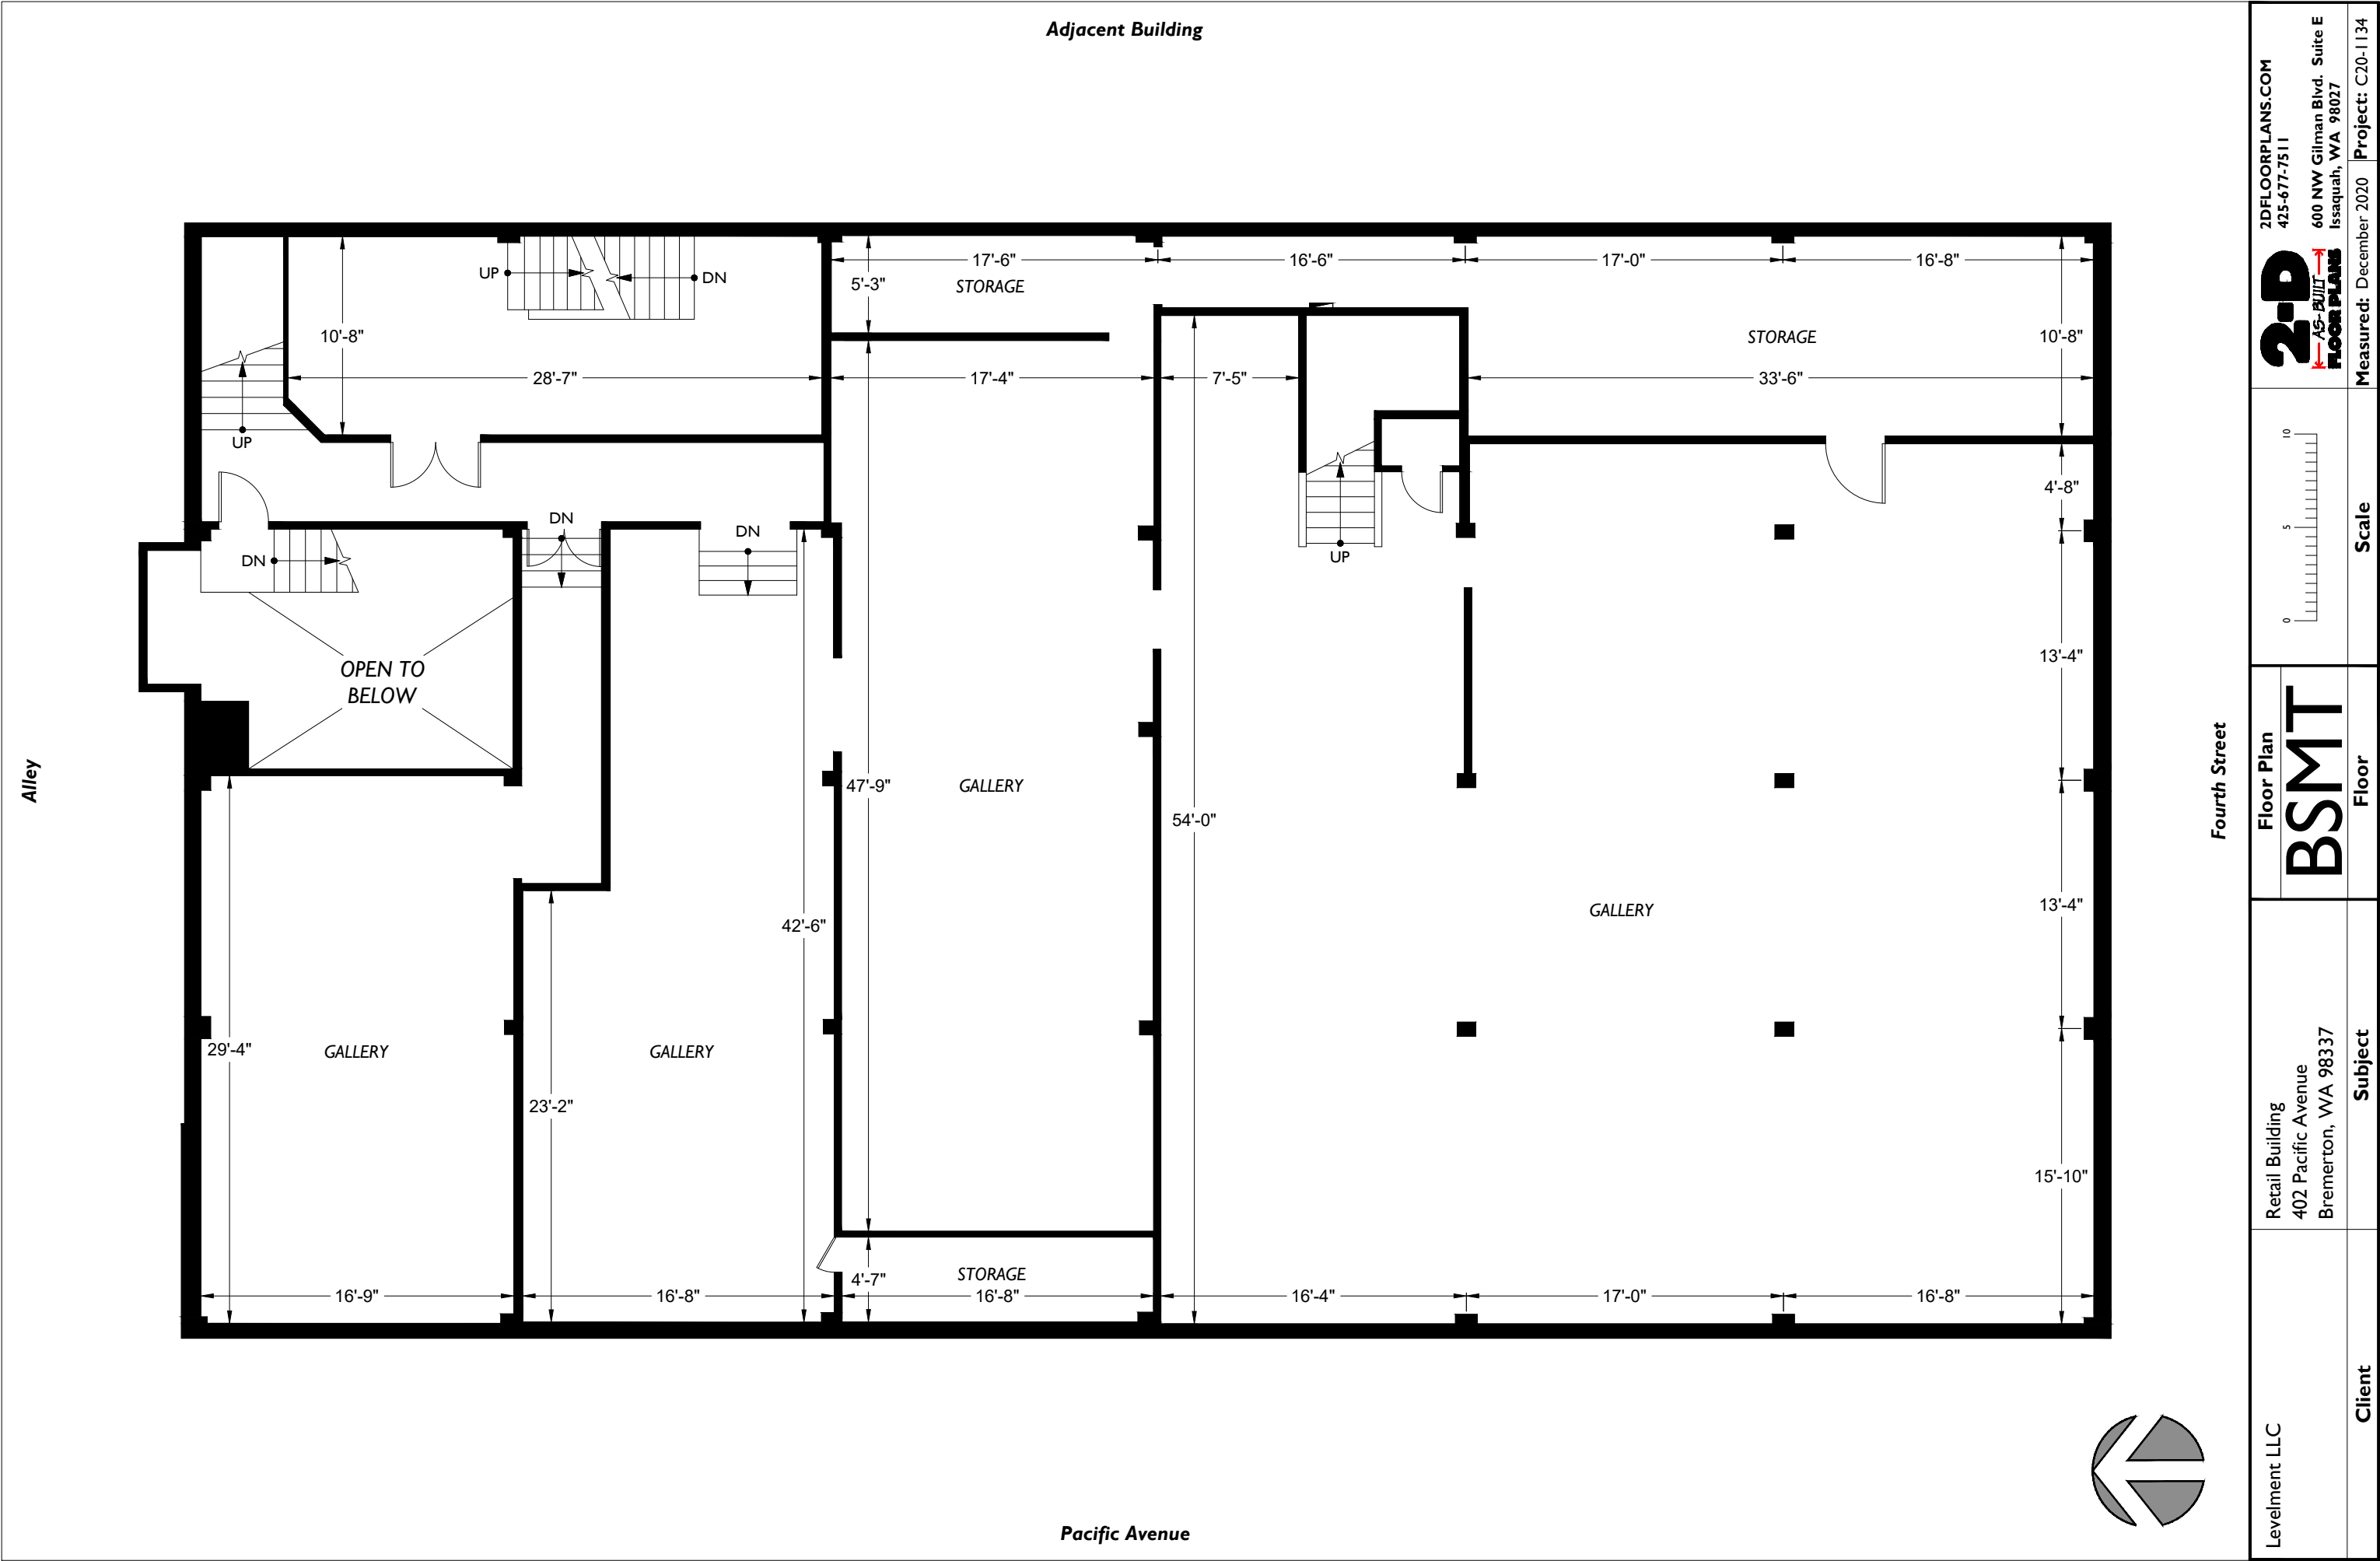

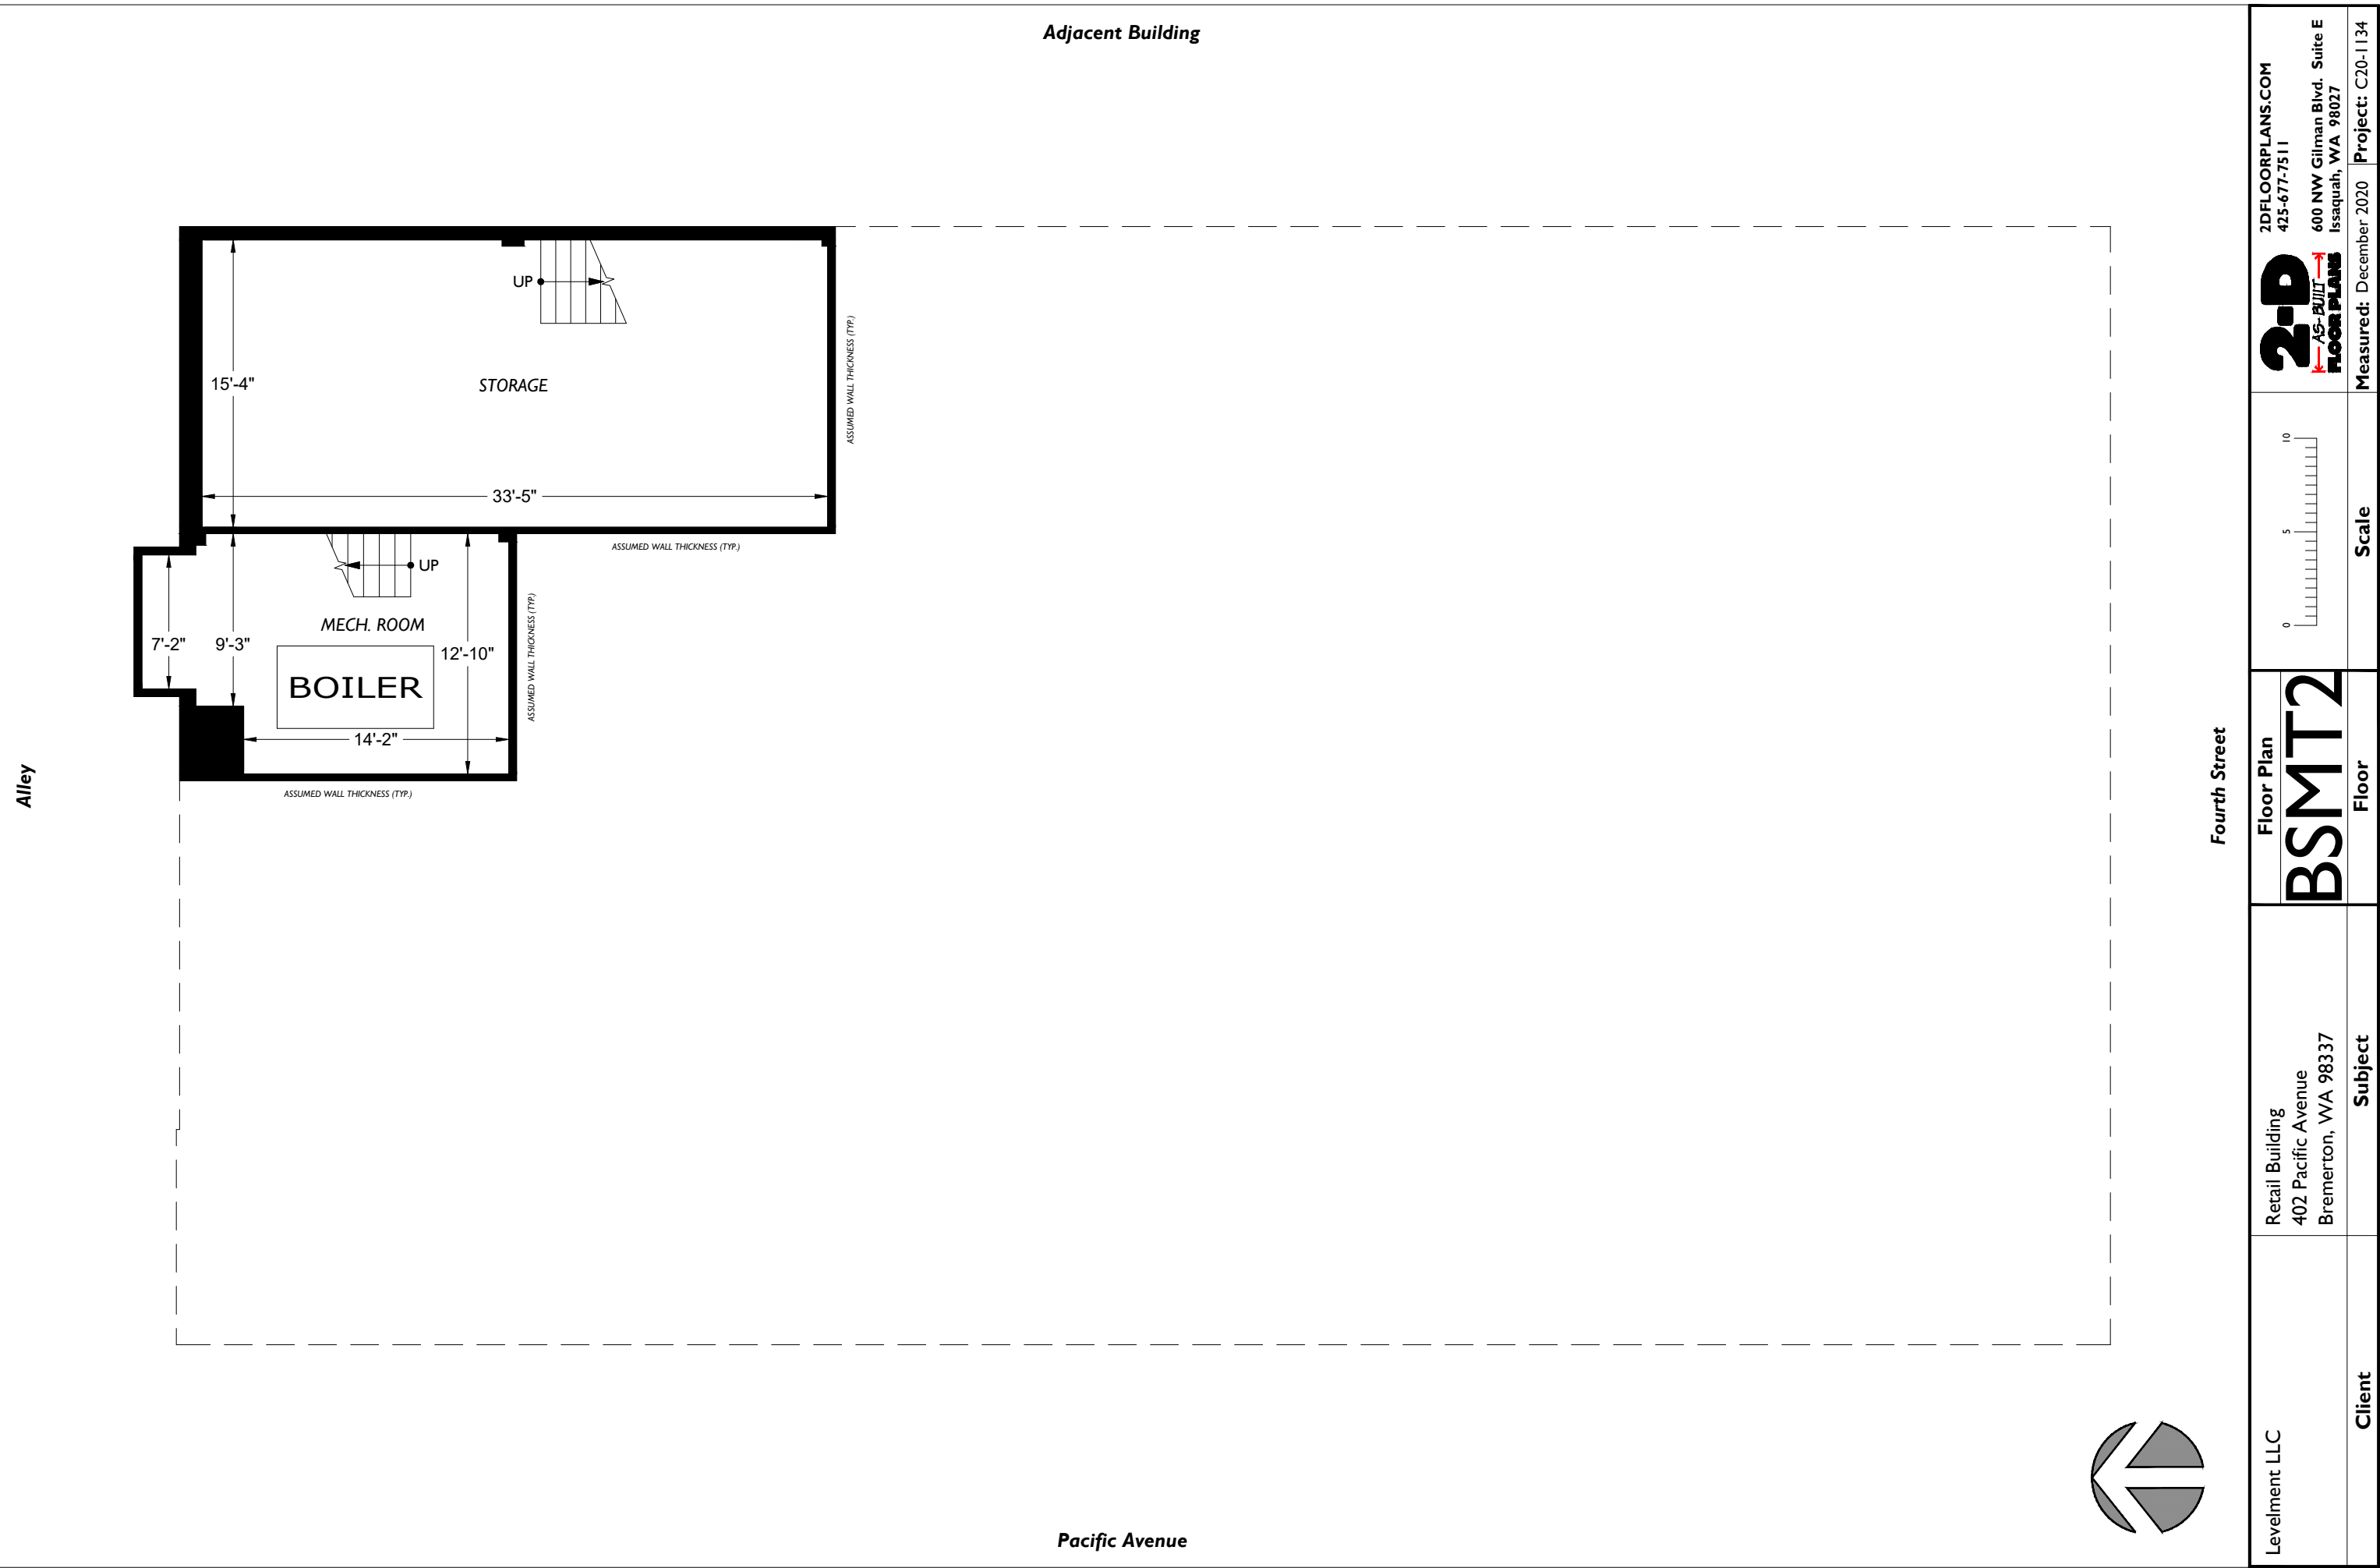

Levelment LLC	Retail Building 402 Pacific Avenue Bremerton, WA 98337	Floor Plan BSMT2	 0 5 10	2-D AS-BUILT FLOOR PLANS	2DFLOORPLANS.COM 425-677-7511 600 NW Gilman Blvd. Suite E Issaquah, WA 98027
Client	Subject	Floor	Scale	Measured: December 2020	Project: C20-1134