


9400
W. HIGGINS

7,044 SF


SUITE 310

AS-BUILT CONDITIONS

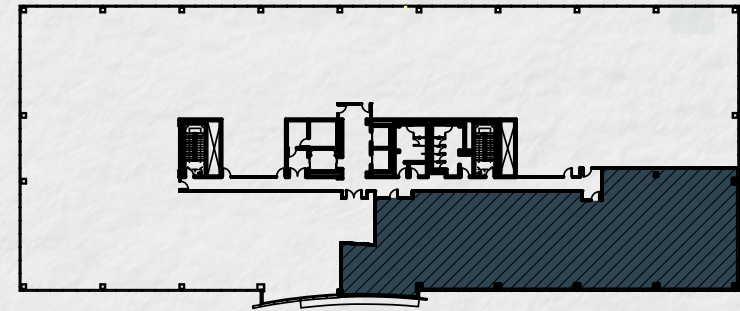

NINETY-FOUR HUNDRED HIGGINS ROAD

ROSEMONT, ILLINOIS, 60018

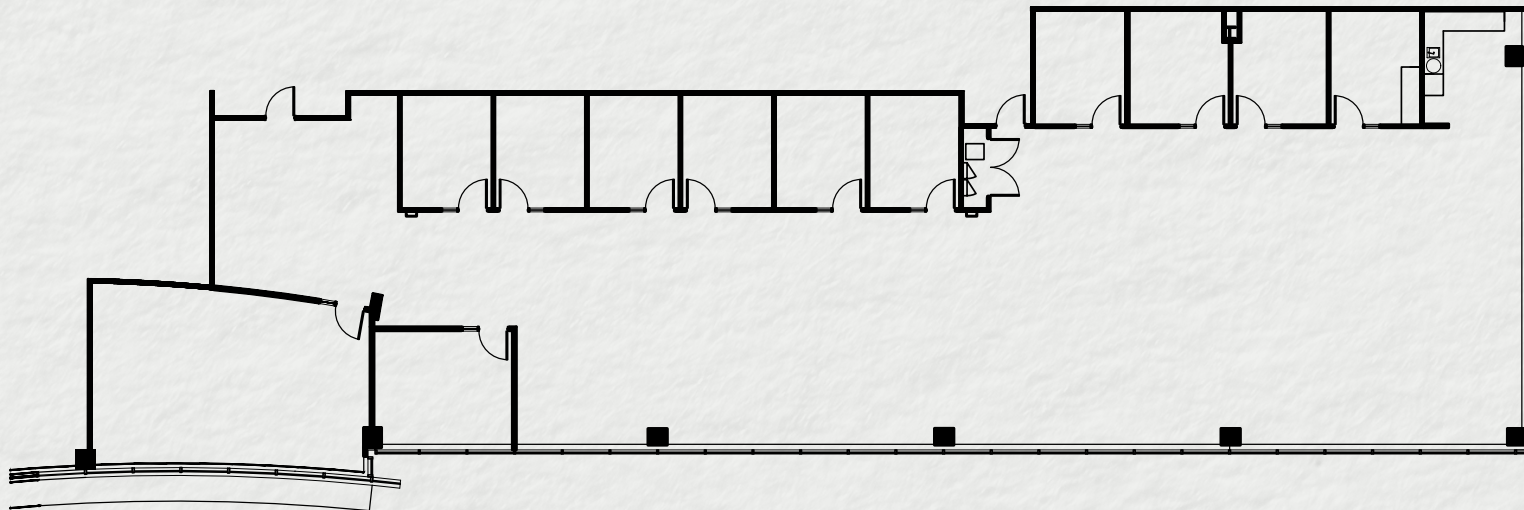

←
NORTH

JOSH CRANE
SENIOR DIRECTOR
+1 312 424 8151
JOSH.CRANE@CUSHWAKE.COM

AAOS
AMERICAN ACADEMY OF
ORTHOPAEDIC SURGEONS

 **CUSHMAN &
WAKEFIELD**