

Property Key



3904 Corporex Drive As Built Marketing Package


3904 Corporex Drive, Tampa, FL 33619

Building: 3
Suite: 150
Sheet: A-1

Scale: Not to Scale
Sheet Size: 8.5" x 11"
Not For Construction



BAY SPACE

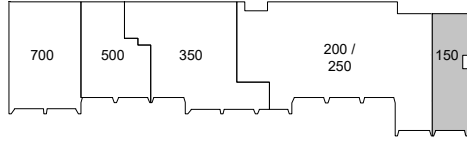

Total Area - 3,802 SF

Building Information

DECK HEIGHT:	17'-4"
CEILING HEIGHT:	8'-11"
CLEAR HEIGHT:	15'-11"
SPRINKLERED:	No

