

ROYAL OAK PROFESSIONAL PLAZA

13203 N 103RD AVE | SUN CITY, AZ 85351


Floor 01

Suite I-7

AS-BUILT

2,840 SF

AVAILABLE

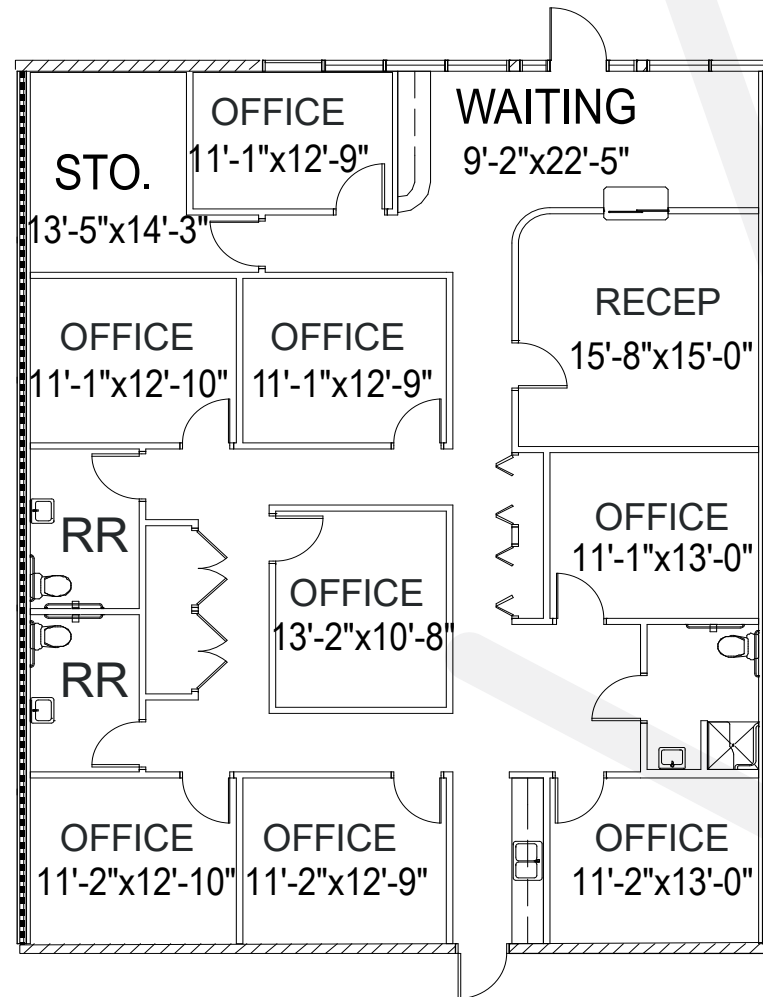

RACHAEL THOMPSON
Senior Vice President
602.513.5122
rachael.thompson@kidder.com

PERRY GABUZZI, CCIM
Senior Vice President
602.513.5116
perry.gabuzzi@kidder.com



View Portfolio

km Kidder
Mathews