


CHANDLER  
MEDICAL  
BUILDING

Floor 01

Suite 115  
AS-BUILT

1,667 SF  
AVAILABLE

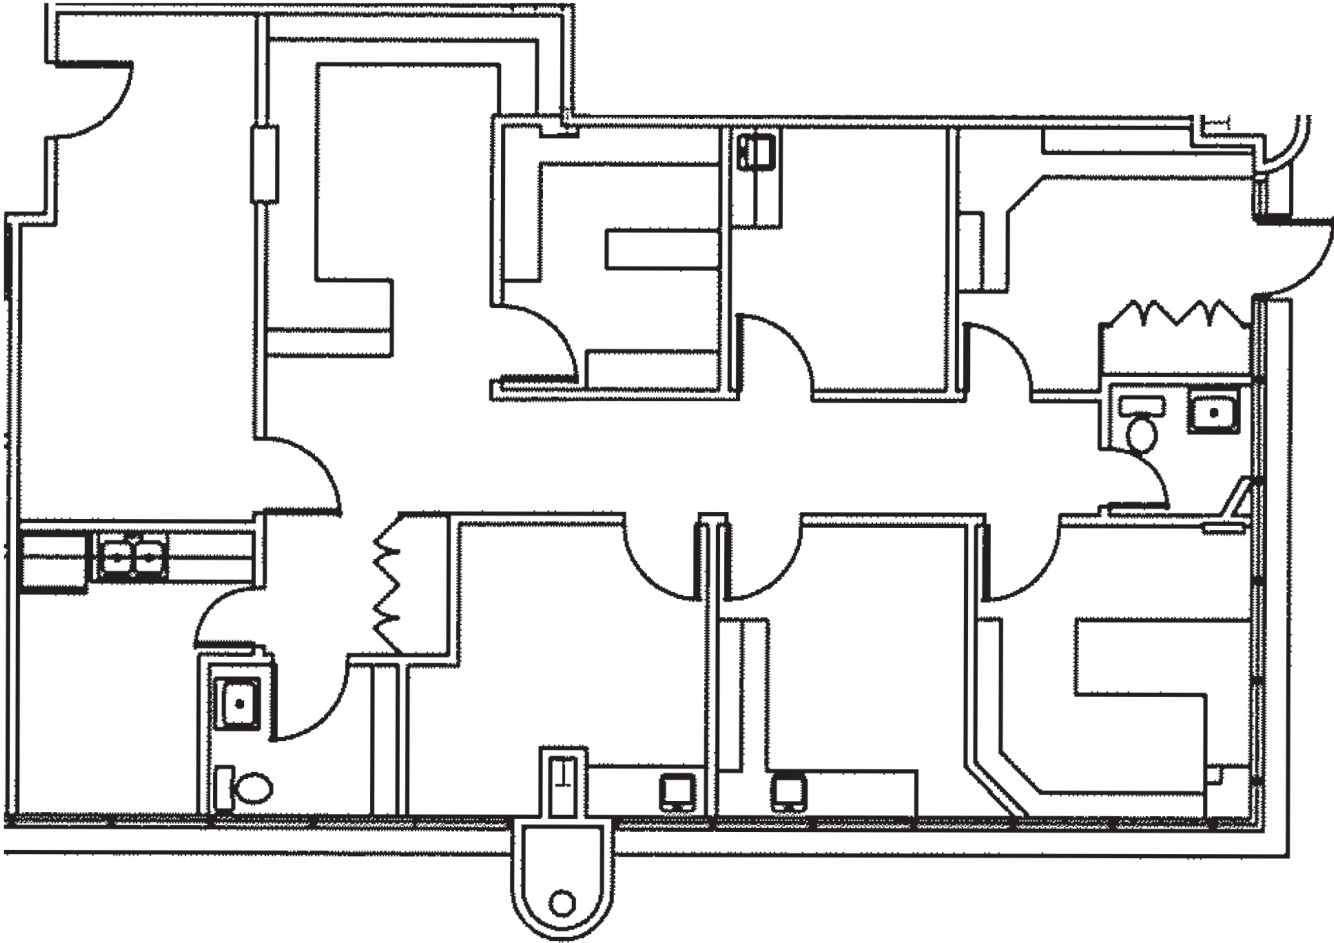

**RACHAEL THOMPSON**  
Senior Vice President  
602.513.5122  
rachael.thompson@kidder.com

**PERRY GABUZZI, CCIM**  
Executive Vice President  
602.513.5116  
perry.gabuzzi@kidder.com