



SUITE 2610
AS-BUILT - 1 OF 1
121 W TRADE
2,769 RSF
SCALE: 3/32" = 1'-0"
DATE: DECEMBER 28, 2022

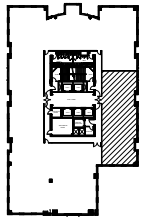

KEY PLAN

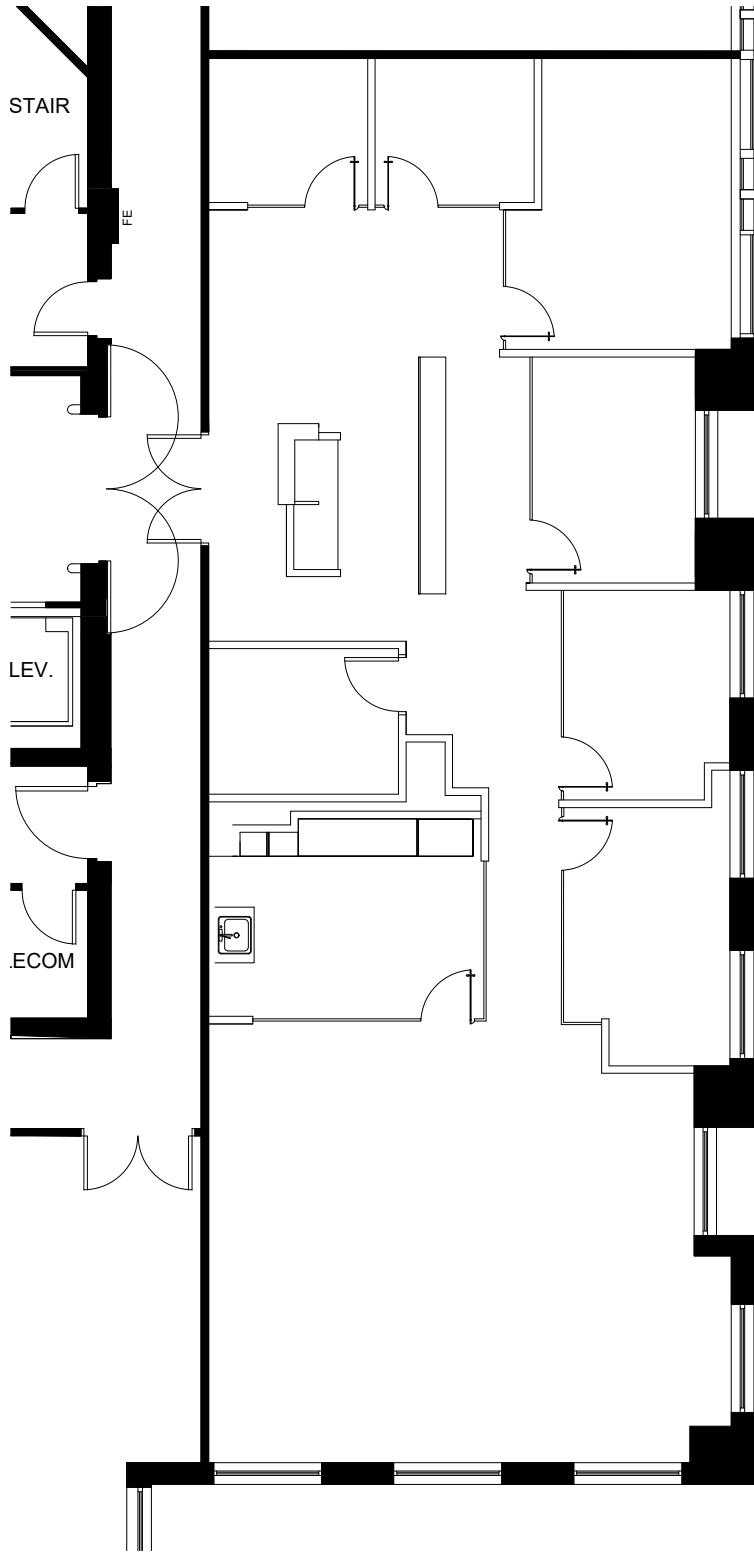

CBRE



**SMITH
HARRIS
DESIGN**
associates