


② NO CLASS in CONFERENCE ROOM
 sigl.

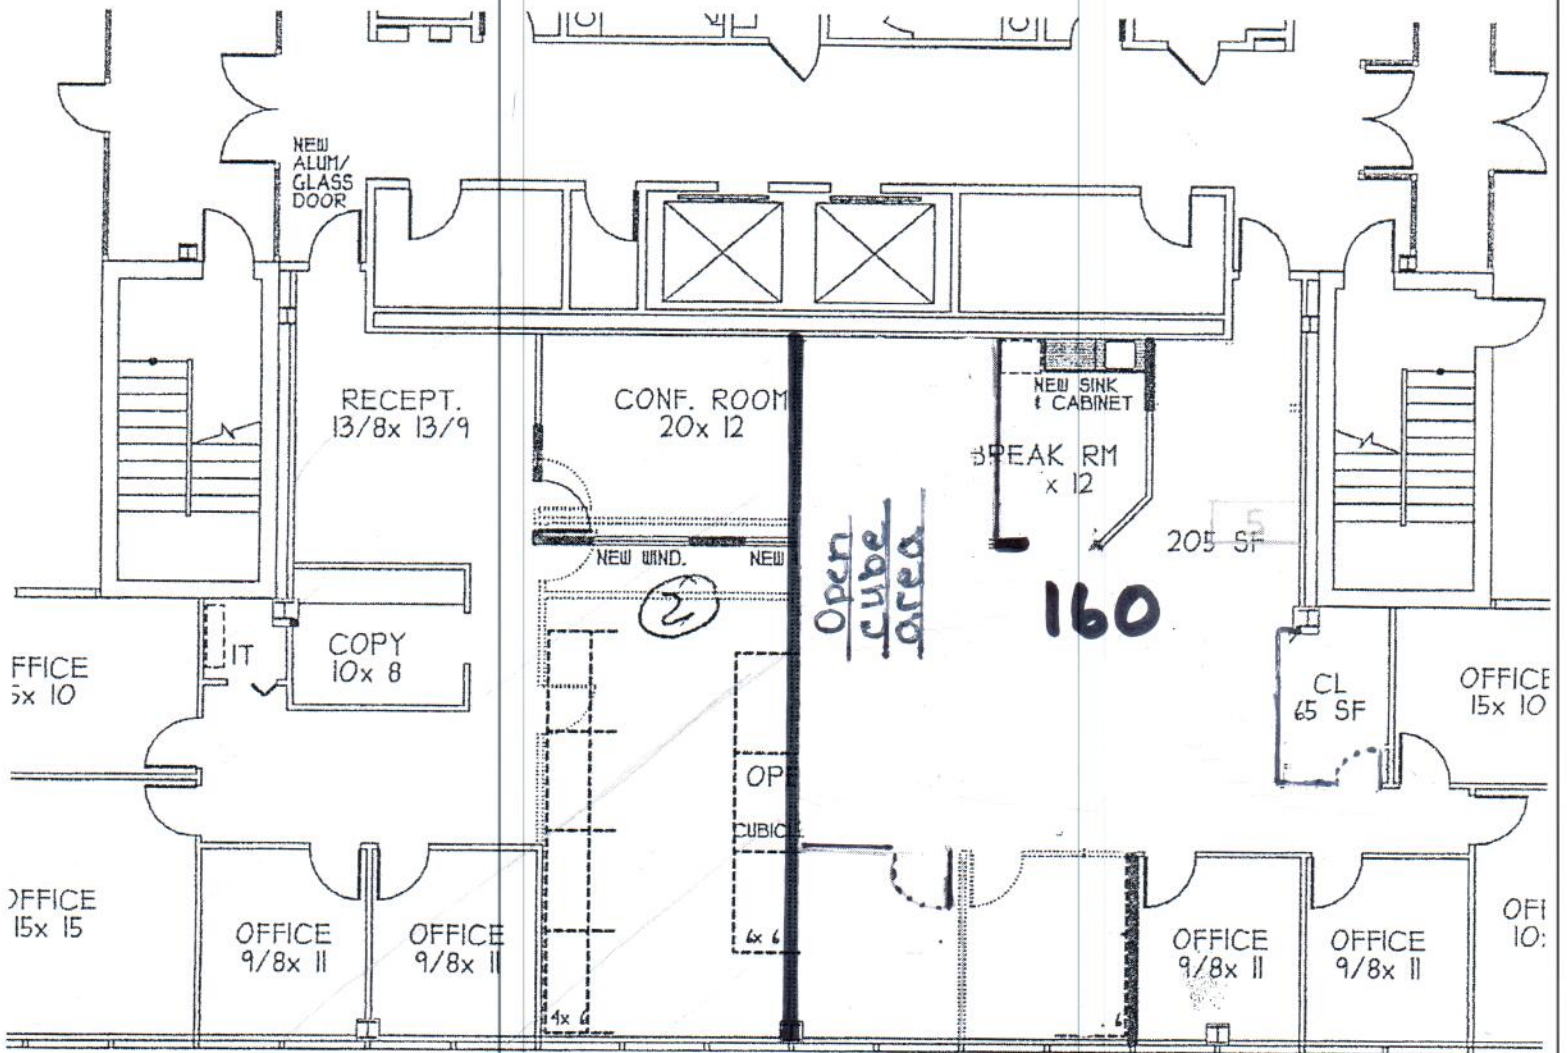


MERIDIAN BANK

SUITE 160/180, 1,000 CRAWFORD PLACE

HARRY D. BOPP AIA
 ARCHITECT
 (609) 654-1425

7-11-20

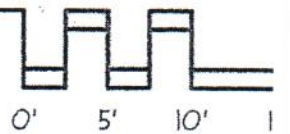

Ok.
 J. Campbell
 MERIDIAN BANK