
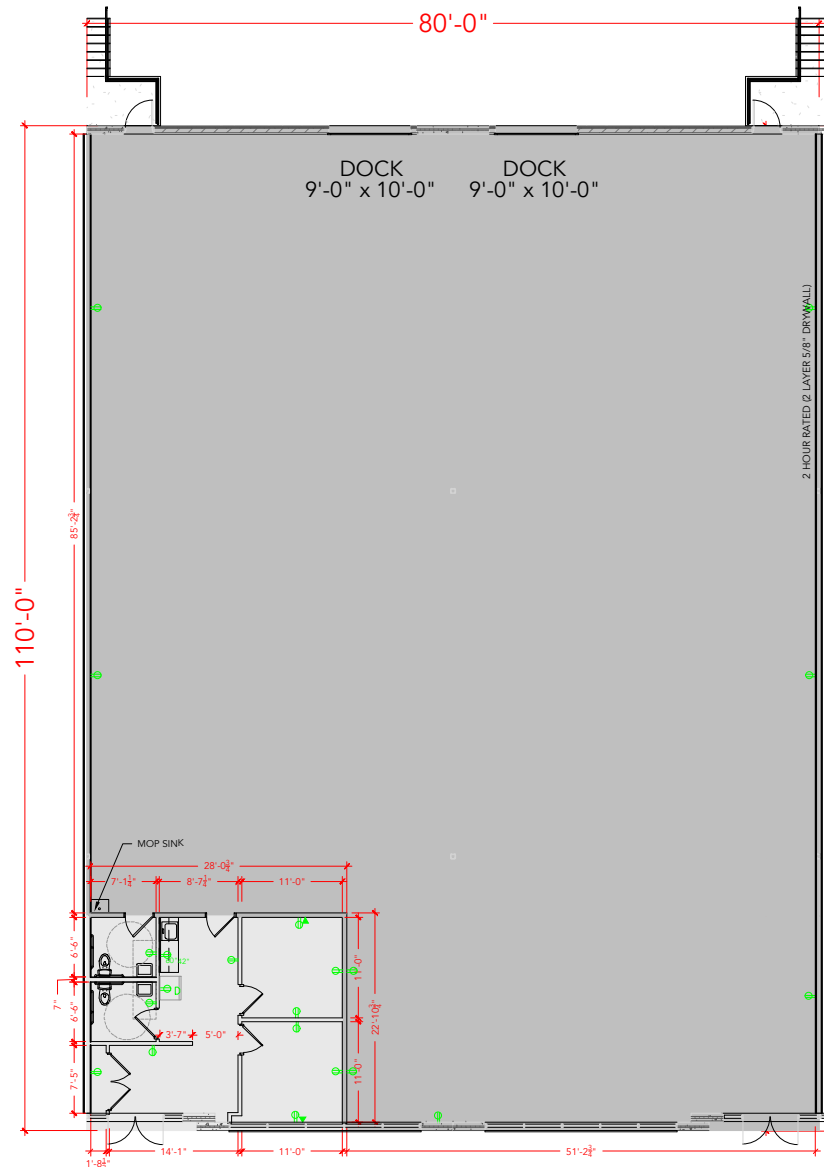


TOTAL SF AVAILABLE - 8,852 RSF

OFFICE - 666 RSF

WAREHOUSE - 8,186 RSF

[Click to access CADD file](#)

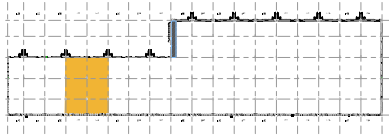

Floor Plan

DRAWING #: IB1-165-170

ASBUILT DATE:NEEDS TO BE