
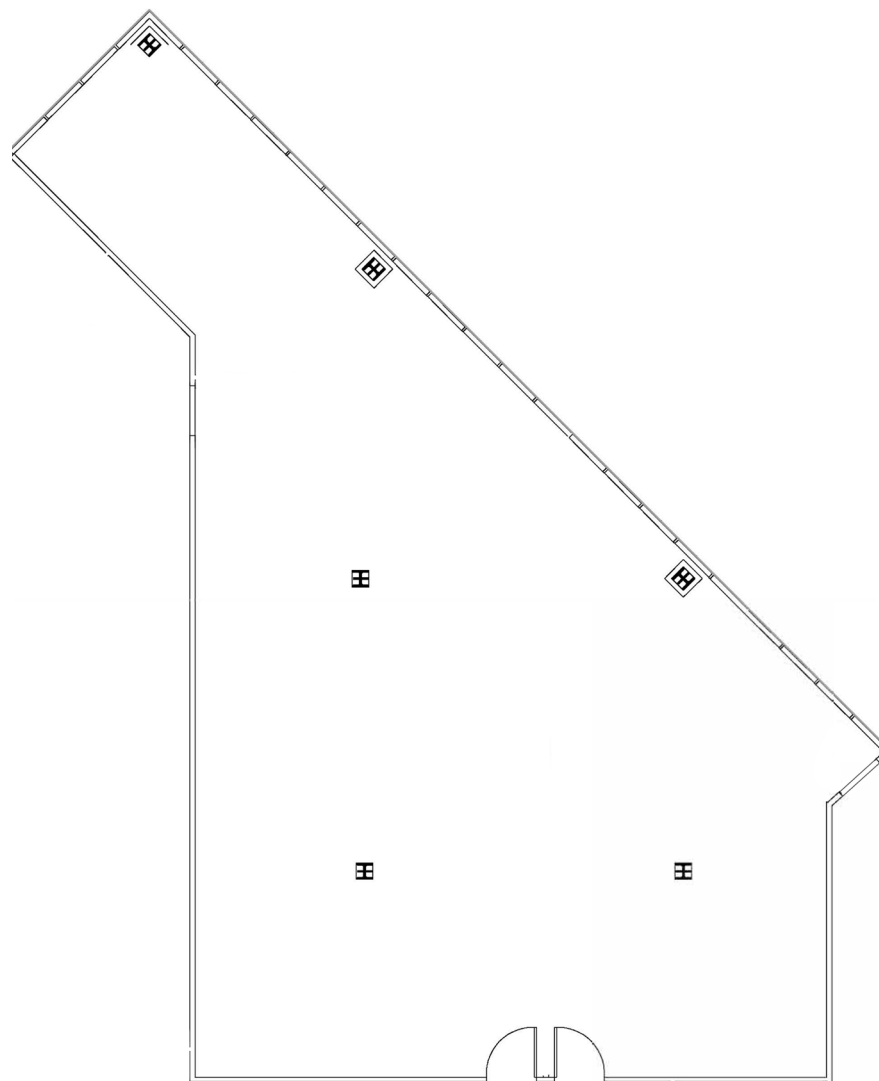


SPACE AVAILABLE

SUITE 300: 3,764 RSF

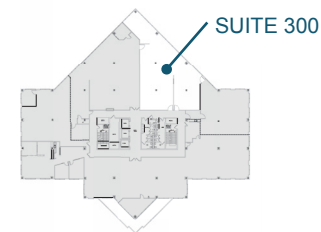

THE POINTE AT 1901
1901 Ulmerton Road
St. Petersburg, FL

No warranty or representation, expressed or implied, is made to the accuracy of information contained herein, and same is submitted subject to errors, change of price, rental or other conditions, withdrawal without notice, and to any special listing conditions imposed by our principals. PLANS NOT TO SCALE

NICK POLO

813.682.6194

Nick.Polo@FranklinSt.com

CHAD RUPP

813.345.5891

Chad.Rupp@FranklinSt.com

FranklinStreet
Licensed Real Estate Broker | FranklinSt.com