

As Built Drawings
2921 SANFORD DRIVE
SUITE 150
CITY OF SANFORD, FL



RIRI

RICHAN&RINCON
ARCHITECTURE

COVER SHEET

2921 SANFORD DRIVE SUITE 150

As Built
Drawings

Project Number 24-010

Date Issue Date

Drawn By MR


Checked By MR

A0

Scale As indicated

GENERAL NOTES:

- BUILDER TO REVIEW AND VERIFY ALL EXISTING CONDITIONS OF PROJECT DOCUMENTS, INCLUDING ALL EXISTING DIMENSIONS. IF DISCREPANCIES ARE DISCOVERED, OWNER MUST BE NOTIFIED PRIOR TO CONSTRUCTION EXECUTION.
- CONTRACTOR TO EVALUATE AND INSPECT ALL EXISTING CONDITIONS AND BECOME FAMILIAR WITH THE EXISTING CONDITIONS PRIOR TO COMMENCEMENT OF CONSTRUCTION.

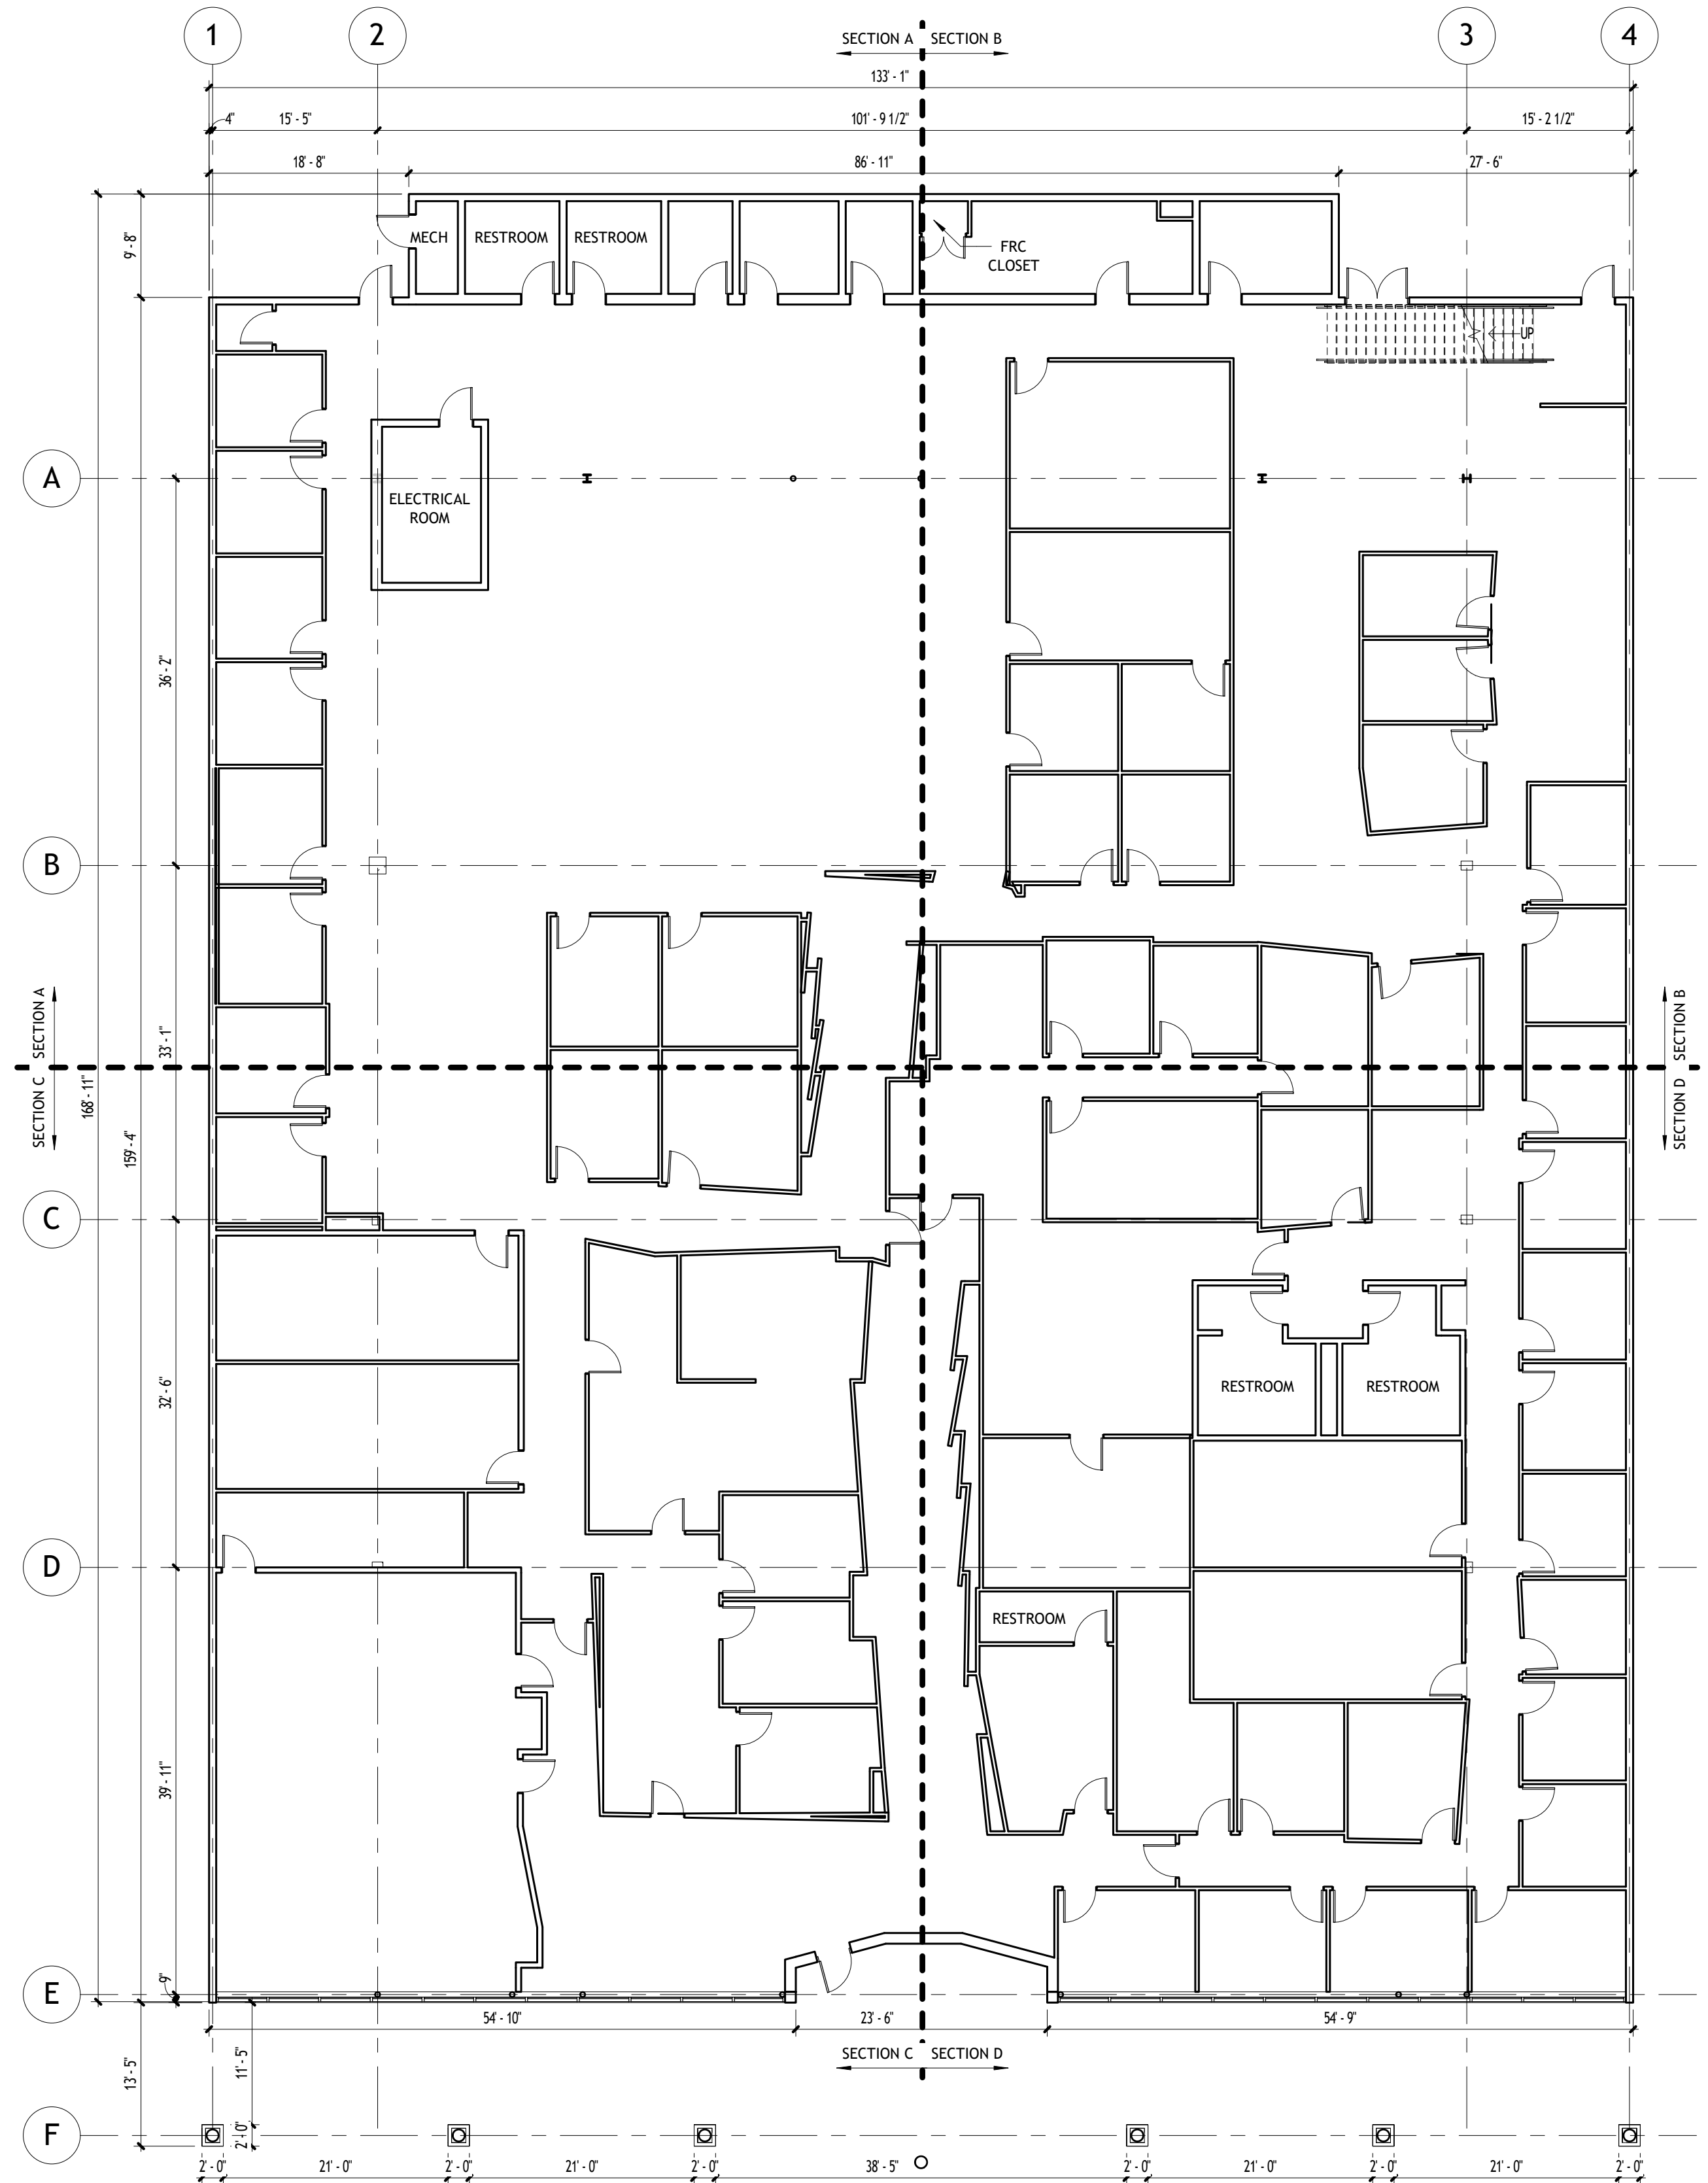

1 BUILDING 1ST FLOOR PLAN
 3/32" = 1'-0"

GENERAL NOTES:
 - BUILDER TO REVIEW AND VERIFY ALL EXISTING CONDITIONS OF PROJECT DOCUMENTS. INCLUDING ALL EXISTING DIMENSIONS. IF DISCREPANCIES ARE DISCOVERED, OWNER MUST BE NOTIFIED PRIOR TO CONSTRUCTION EXECUTION.
 - CONTRACTOR TO EVALUATE AND INSPECT ALL EXISTING CONDITIONS AND BECOME FAMILIAR WITH THE EXISTING CONDITIONS PRIOR TO COMMENCEMENT OF CONSTRUCTION.

RIRI

RICHANIRINCON
 ARCHITECTURE

BUILDING 1ST FLOOR PLAN

2921 SANFORD DRIVE SUITE 150

As Built
 Drawings

Project Number	24-010
Date	Issue Date
Drawn By	MR
Checked By	MR

A1a0

Scale As indicated

RIRI

RICHANIRINCON
ARCHITECTURE

BUILDING 1ST FLOOR PLAN - SECTION A


2921 SANFORD DRIVE SUITE 150

As Built
Drawings

Project Number	24-010
Date	Issue Date
Drawn By	MR
Checked By	MR

A1a1

Scale As indicated

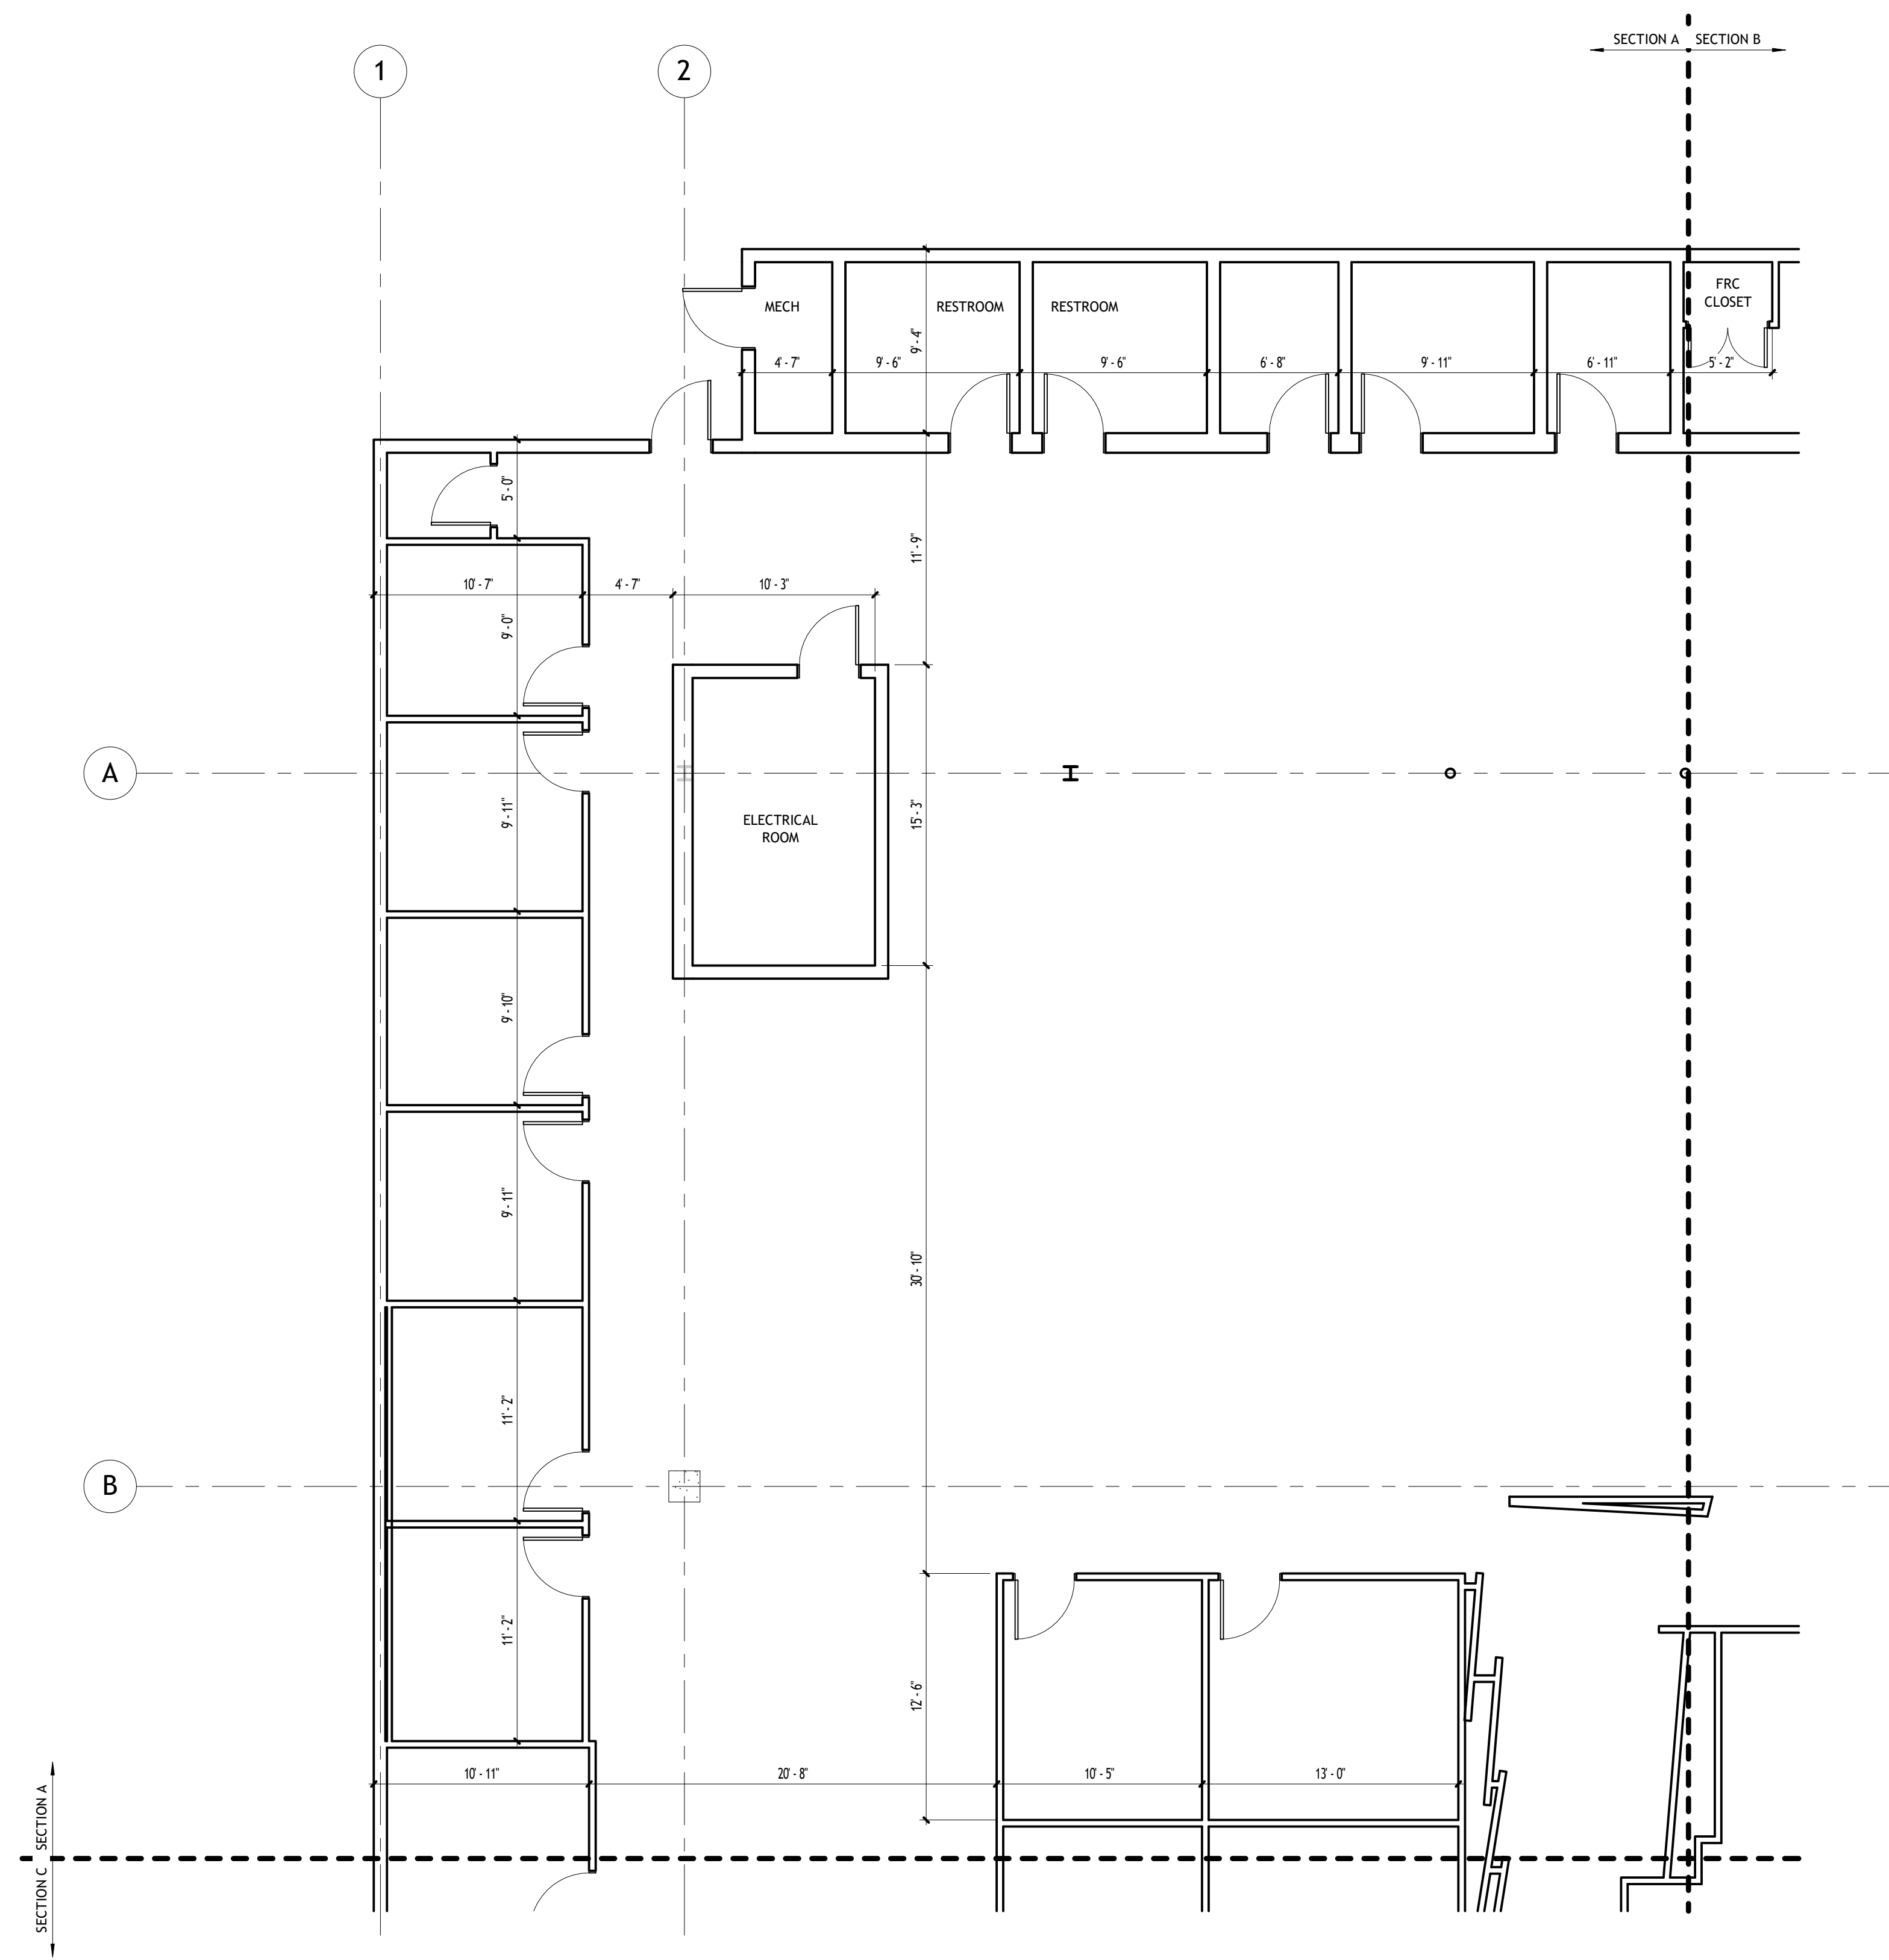

1 BUILDING 1ST FLOOR PLAN - SECTION A
3/16" = 1'-0"

GENERAL NOTES:
- BUILDER TO REVIEW AND VERIFY ALL EXISTING CONDITIONS OF PROJECT DOCUMENTS, INCLUDING ALL EXISTING DIMENSIONS. IF DISCREPANCIES ARE DISCOVERED, OWNER MUST BE NOTIFIED PRIOR TO CONSTRUCTION EXECUTION.
- CONTRACTOR TO EVALUATE AND INSPECT ALL EXISTING CONDITIONS AND BECOME FAMILIAR WITH THE EXISTING CONDITIONS PRIOR TO COMMENCEMENT OF CONSTRUCTION.

RIRI

RICHAN&RINCON
ARCHITECTURE

BUILDING 1ST FLOOR PLAN - SECTION B


2921 SANFORD DRIVE SUITE 150

As Built
Drawings

Project Number	24-010
Date	Issue Date
Drawn By	MR
Checked By	MR


A1a2

Scale As indicated

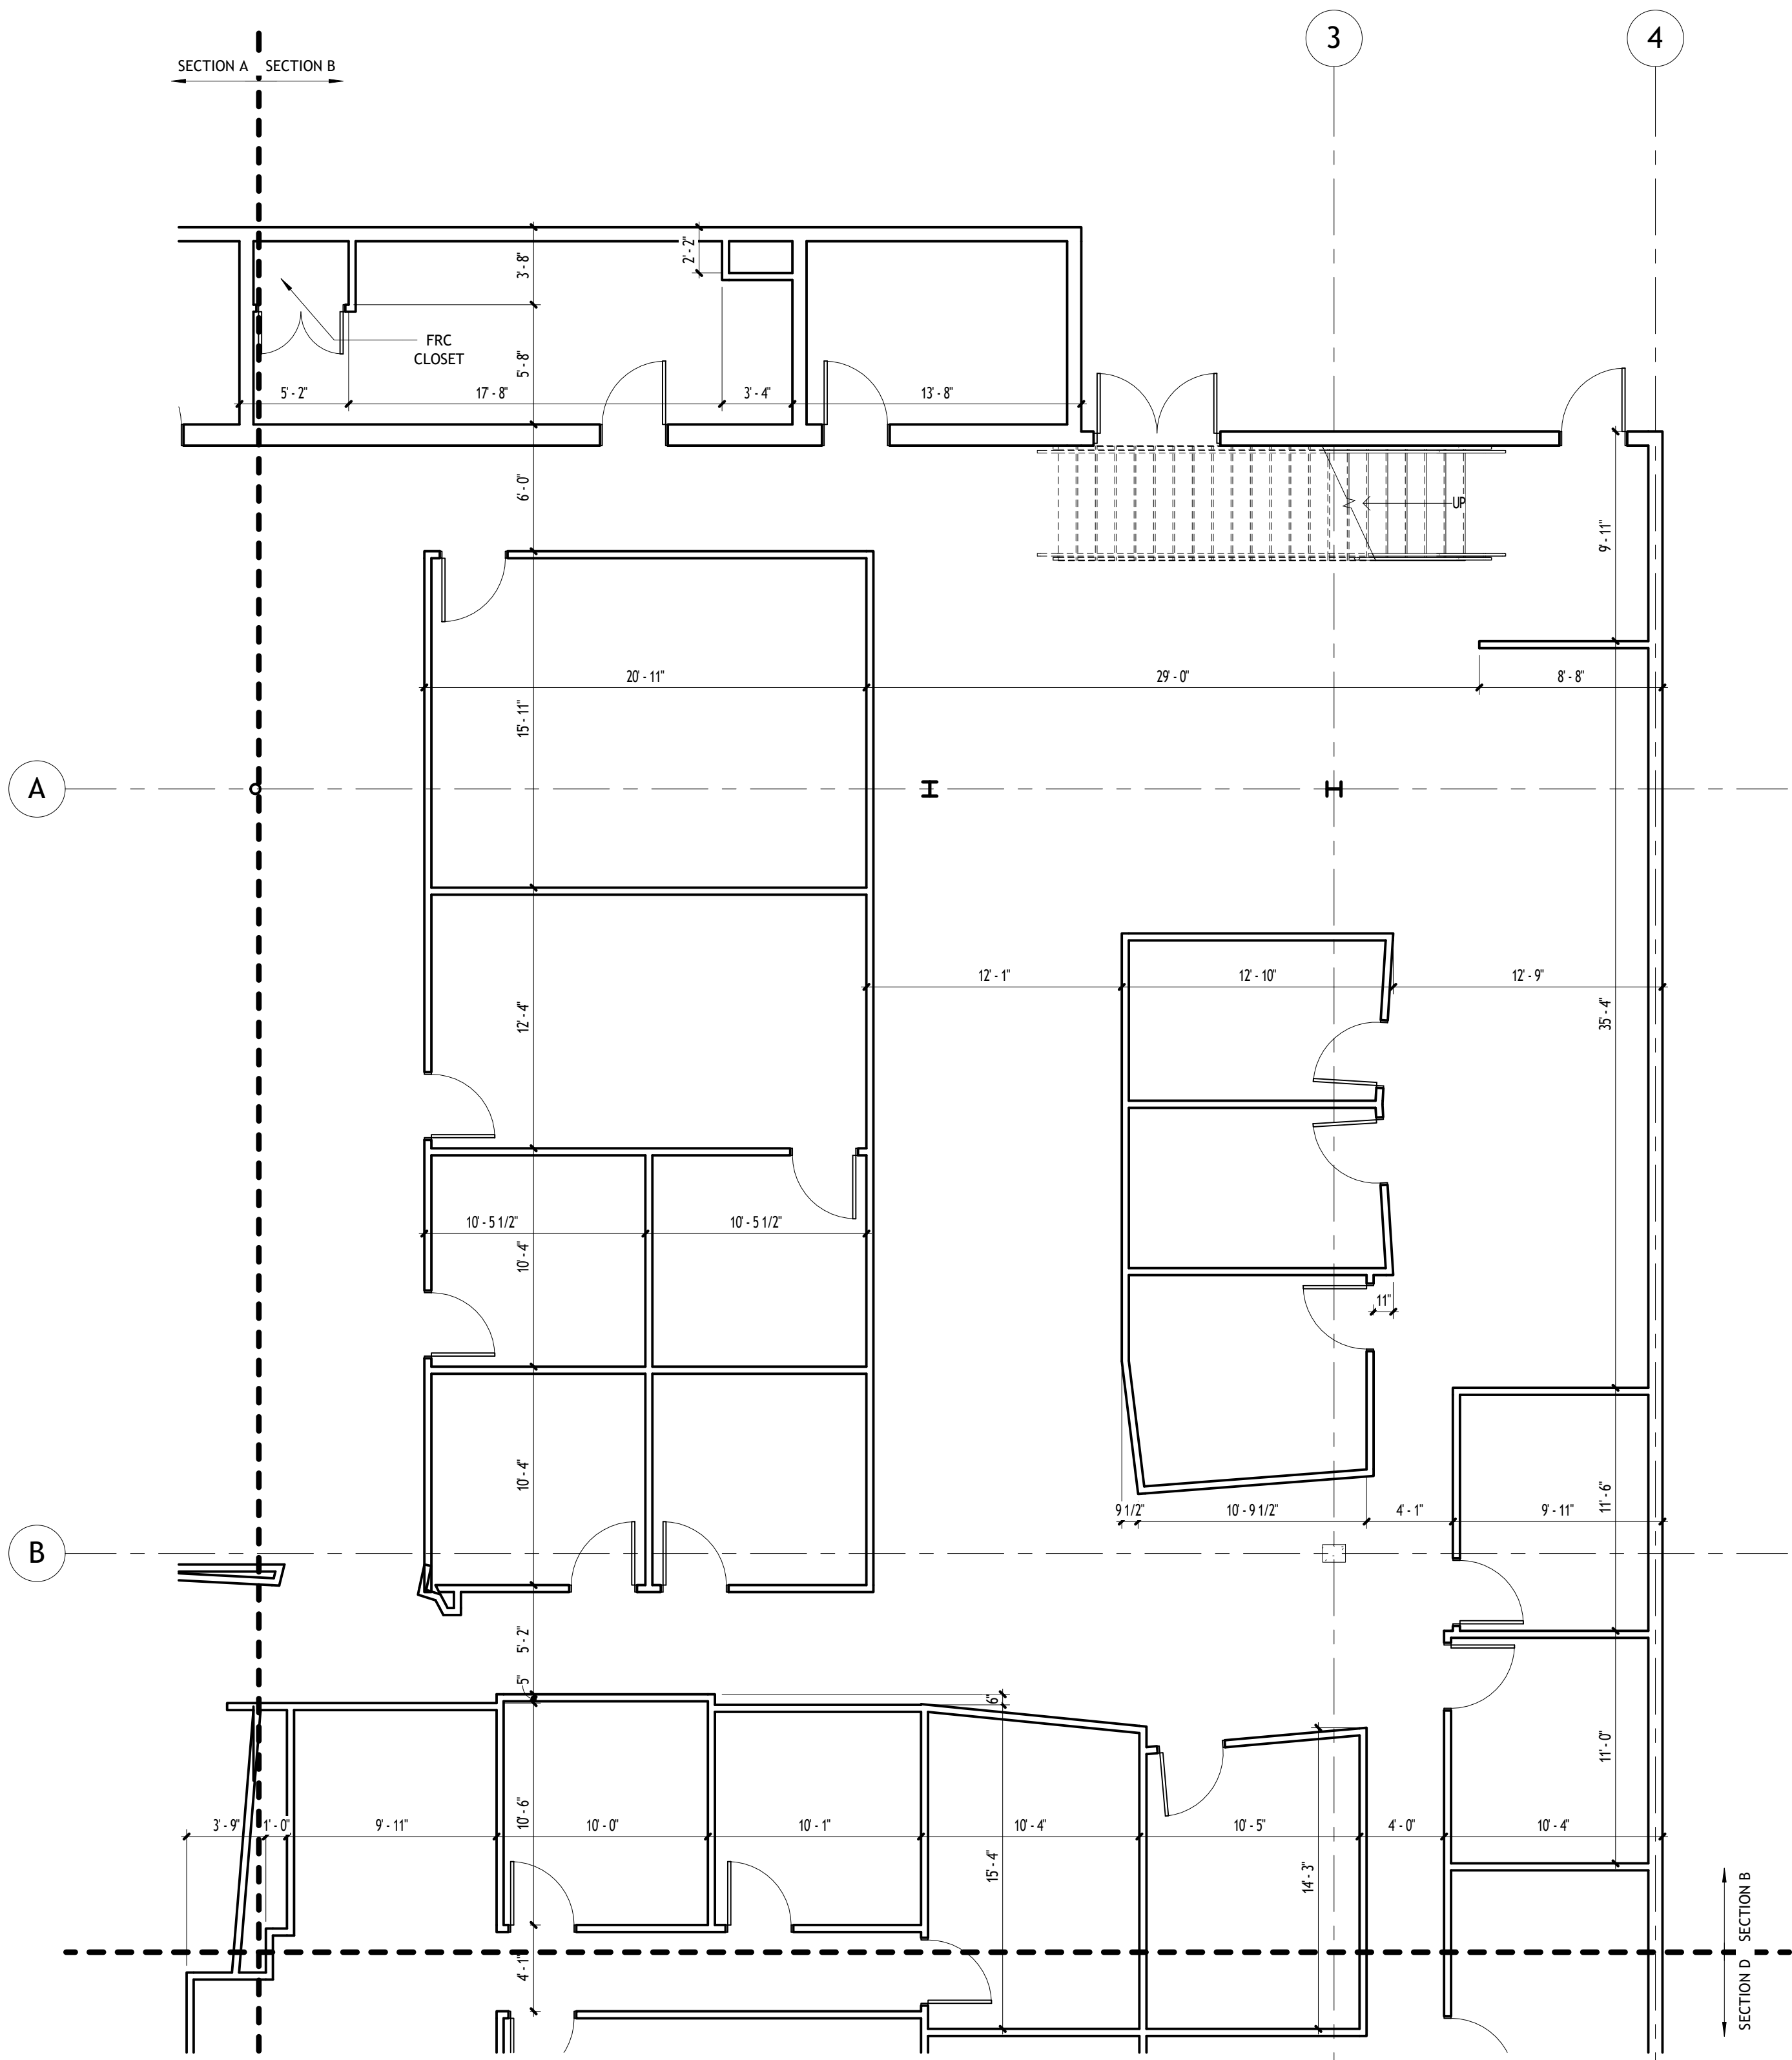

1 BUILDING 1ST FLOOR PLAN - SECTION B
3/16" = 1'-0"

GENERAL NOTES:
- BUILDER TO REVIEW AND VERIFY ALL EXISTING CONDITIONS OF PROJECT DOCUMENTS. INCLUDING ALL EXISTING DIMENSIONS. IF DISCREPANCIES ARE DISCOVERED, OWNER MUST BE NOTIFIED PRIOR TO CONSTRUCTION EXECUTION.
- CONTRACTOR TO EVALUATE AND INSPECT ALL EXISTING CONDITIONS AND BECOME FAMILIAR WITH THE EXISTING CONDITIONS PRIOR TO COMMENCEMENT OF CONSTRUCTION.

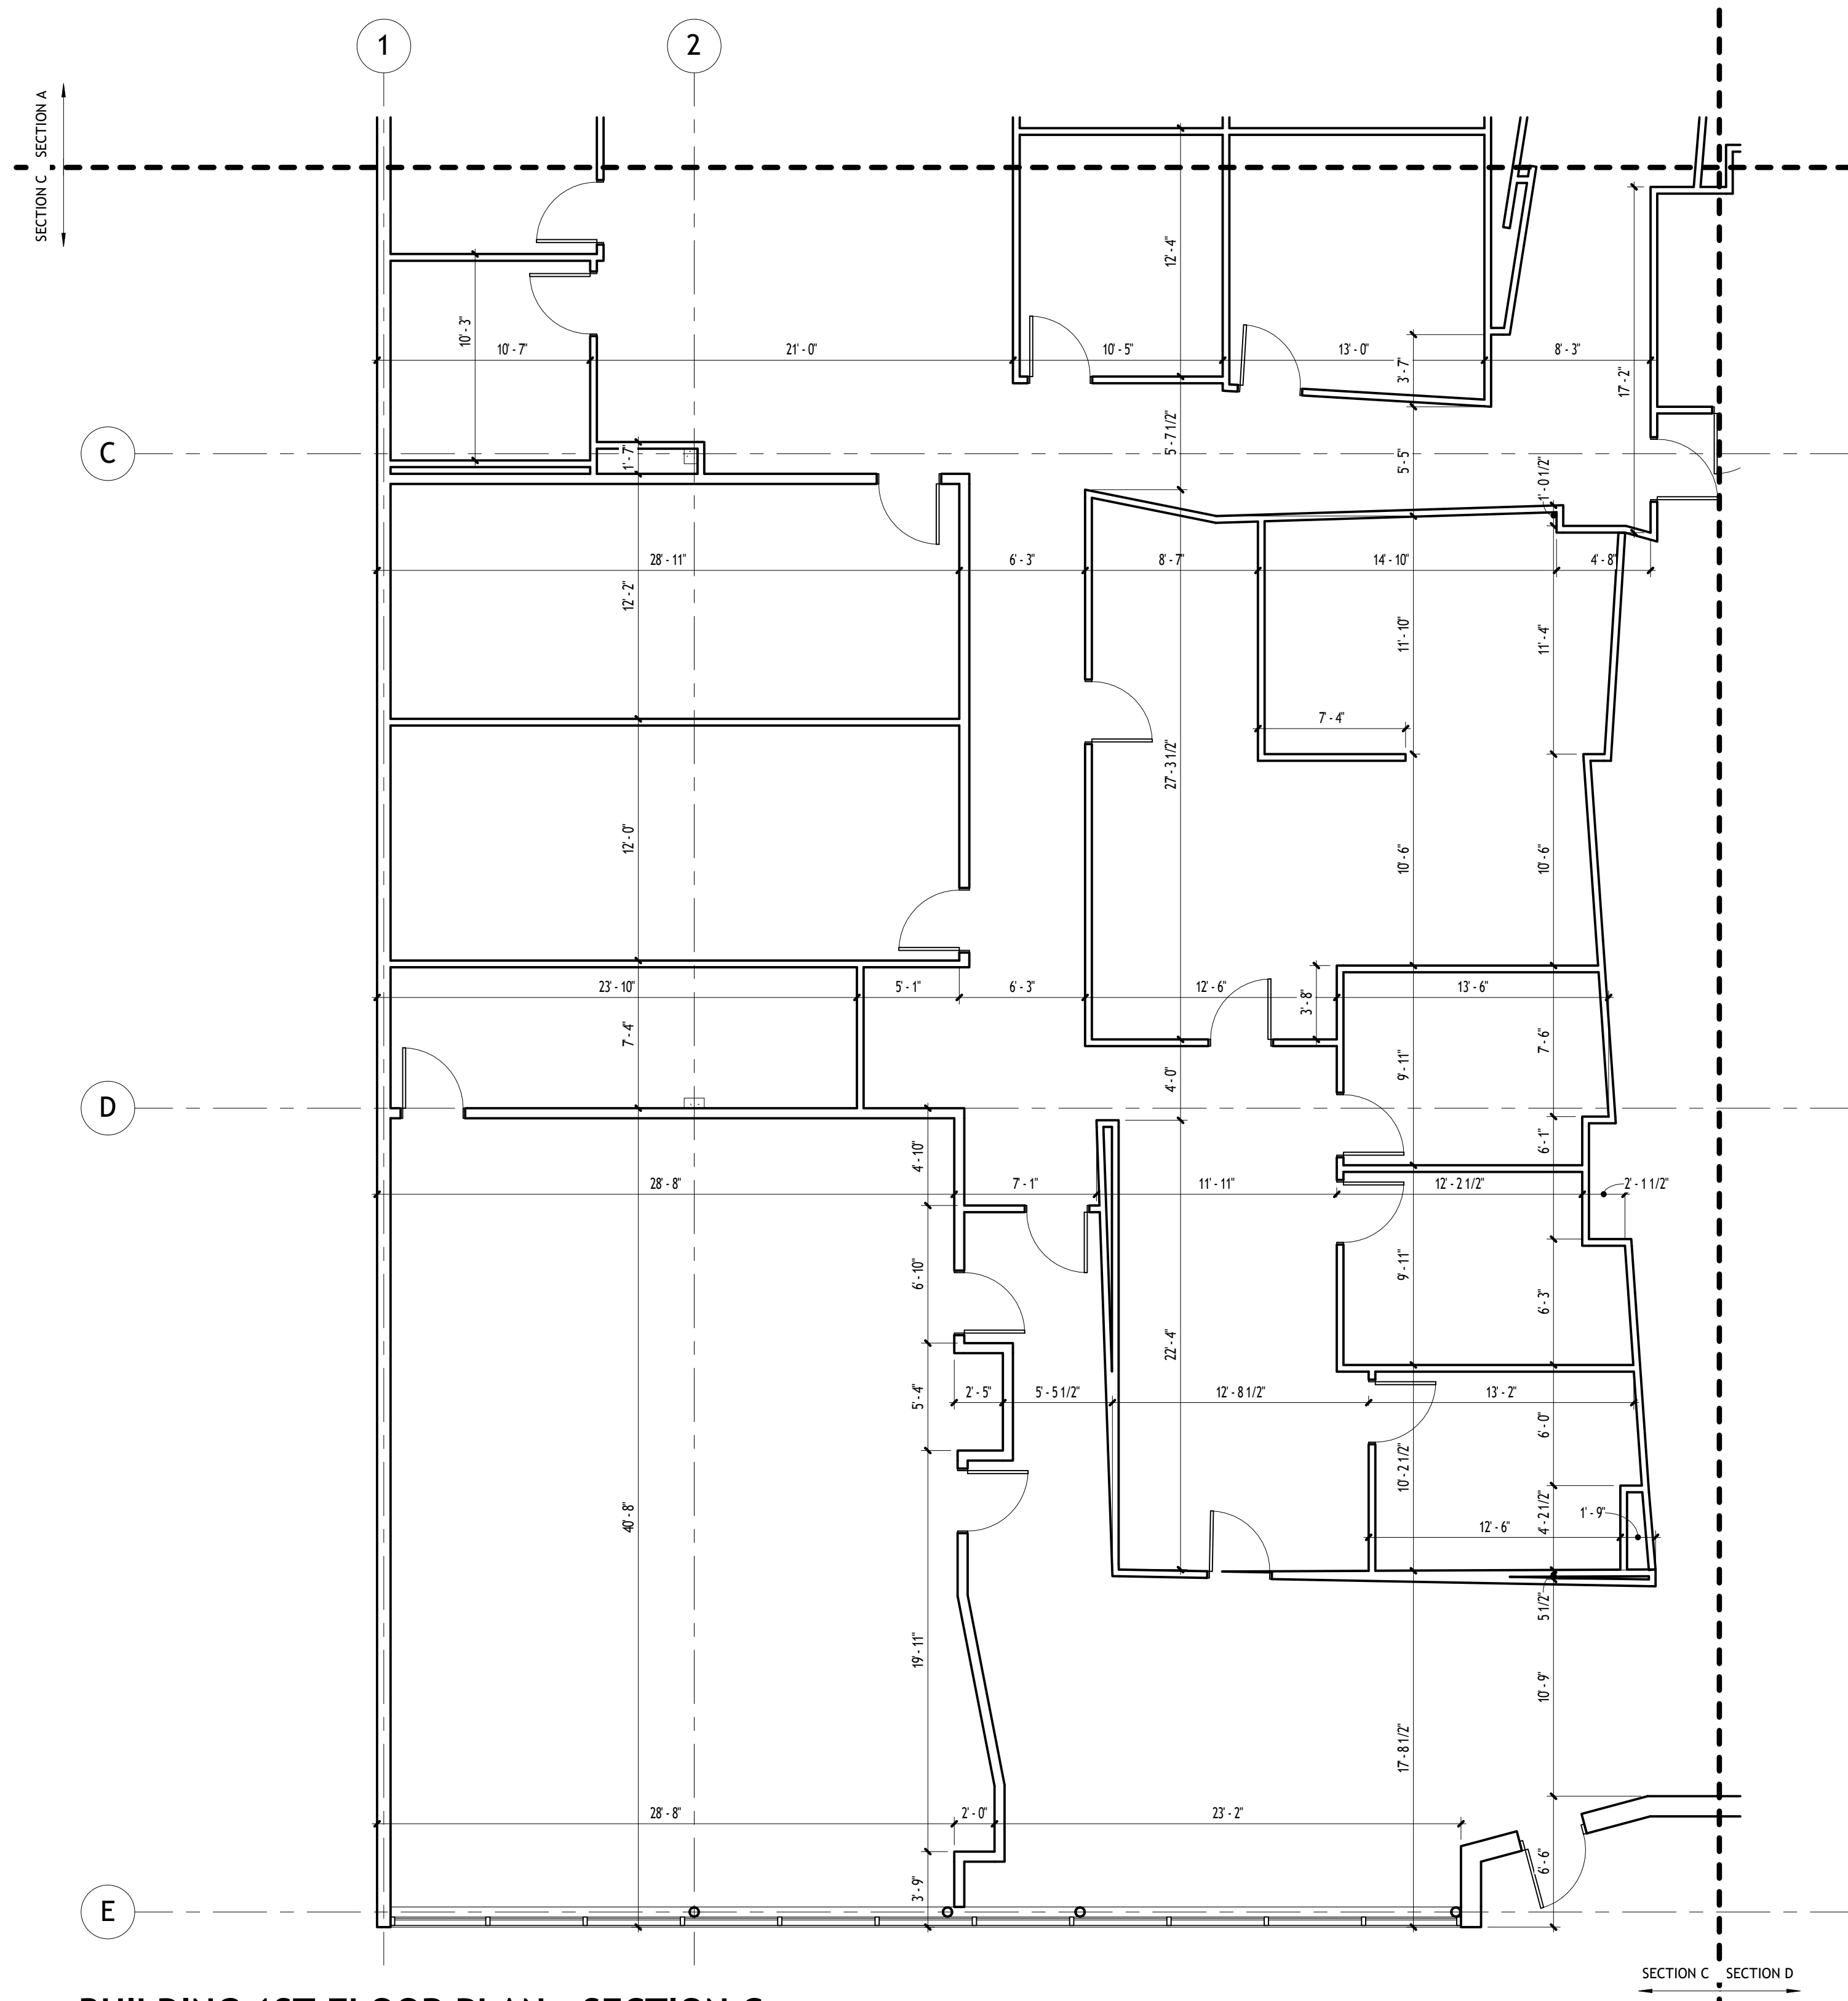

1 BUILDING 1ST FLOOR PLAN - SECTION C
 3/16" = 1'-0"

RIRI

RICHAN&RINCON
 ARCHITECTURE

BUILDING 1ST FLOOR PLAN - SECTION C

2921 SANFORD DRIVE SUITE 150


**As Built
 Drawings**

Project Number	24-010
Date	Issue Date
Drawn By	MR
Checked By	MR

A1a3

Scale As indicated

GENERAL NOTES:
 - BUILDER TO REVIEW AND VERIFY ALL EXISTING CONDITIONS OF PROJECT DOCUMENTS, INCLUDING ALL EXISTING DIMENSIONS. IF DISCREPANCIES ARE DISCOVERED, OWNER MUST BE NOTIFIED PRIOR TO CONSTRUCTION EXECUTION.
 - CONTRACTOR TO EVALUATE AND INSPECT ALL EXISTING CONDITIONS AND BECOME FAMILIAR WITH THE EXISTING CONDITIONS PRIOR TO COMMENCEMENT OF CONSTRUCTION.

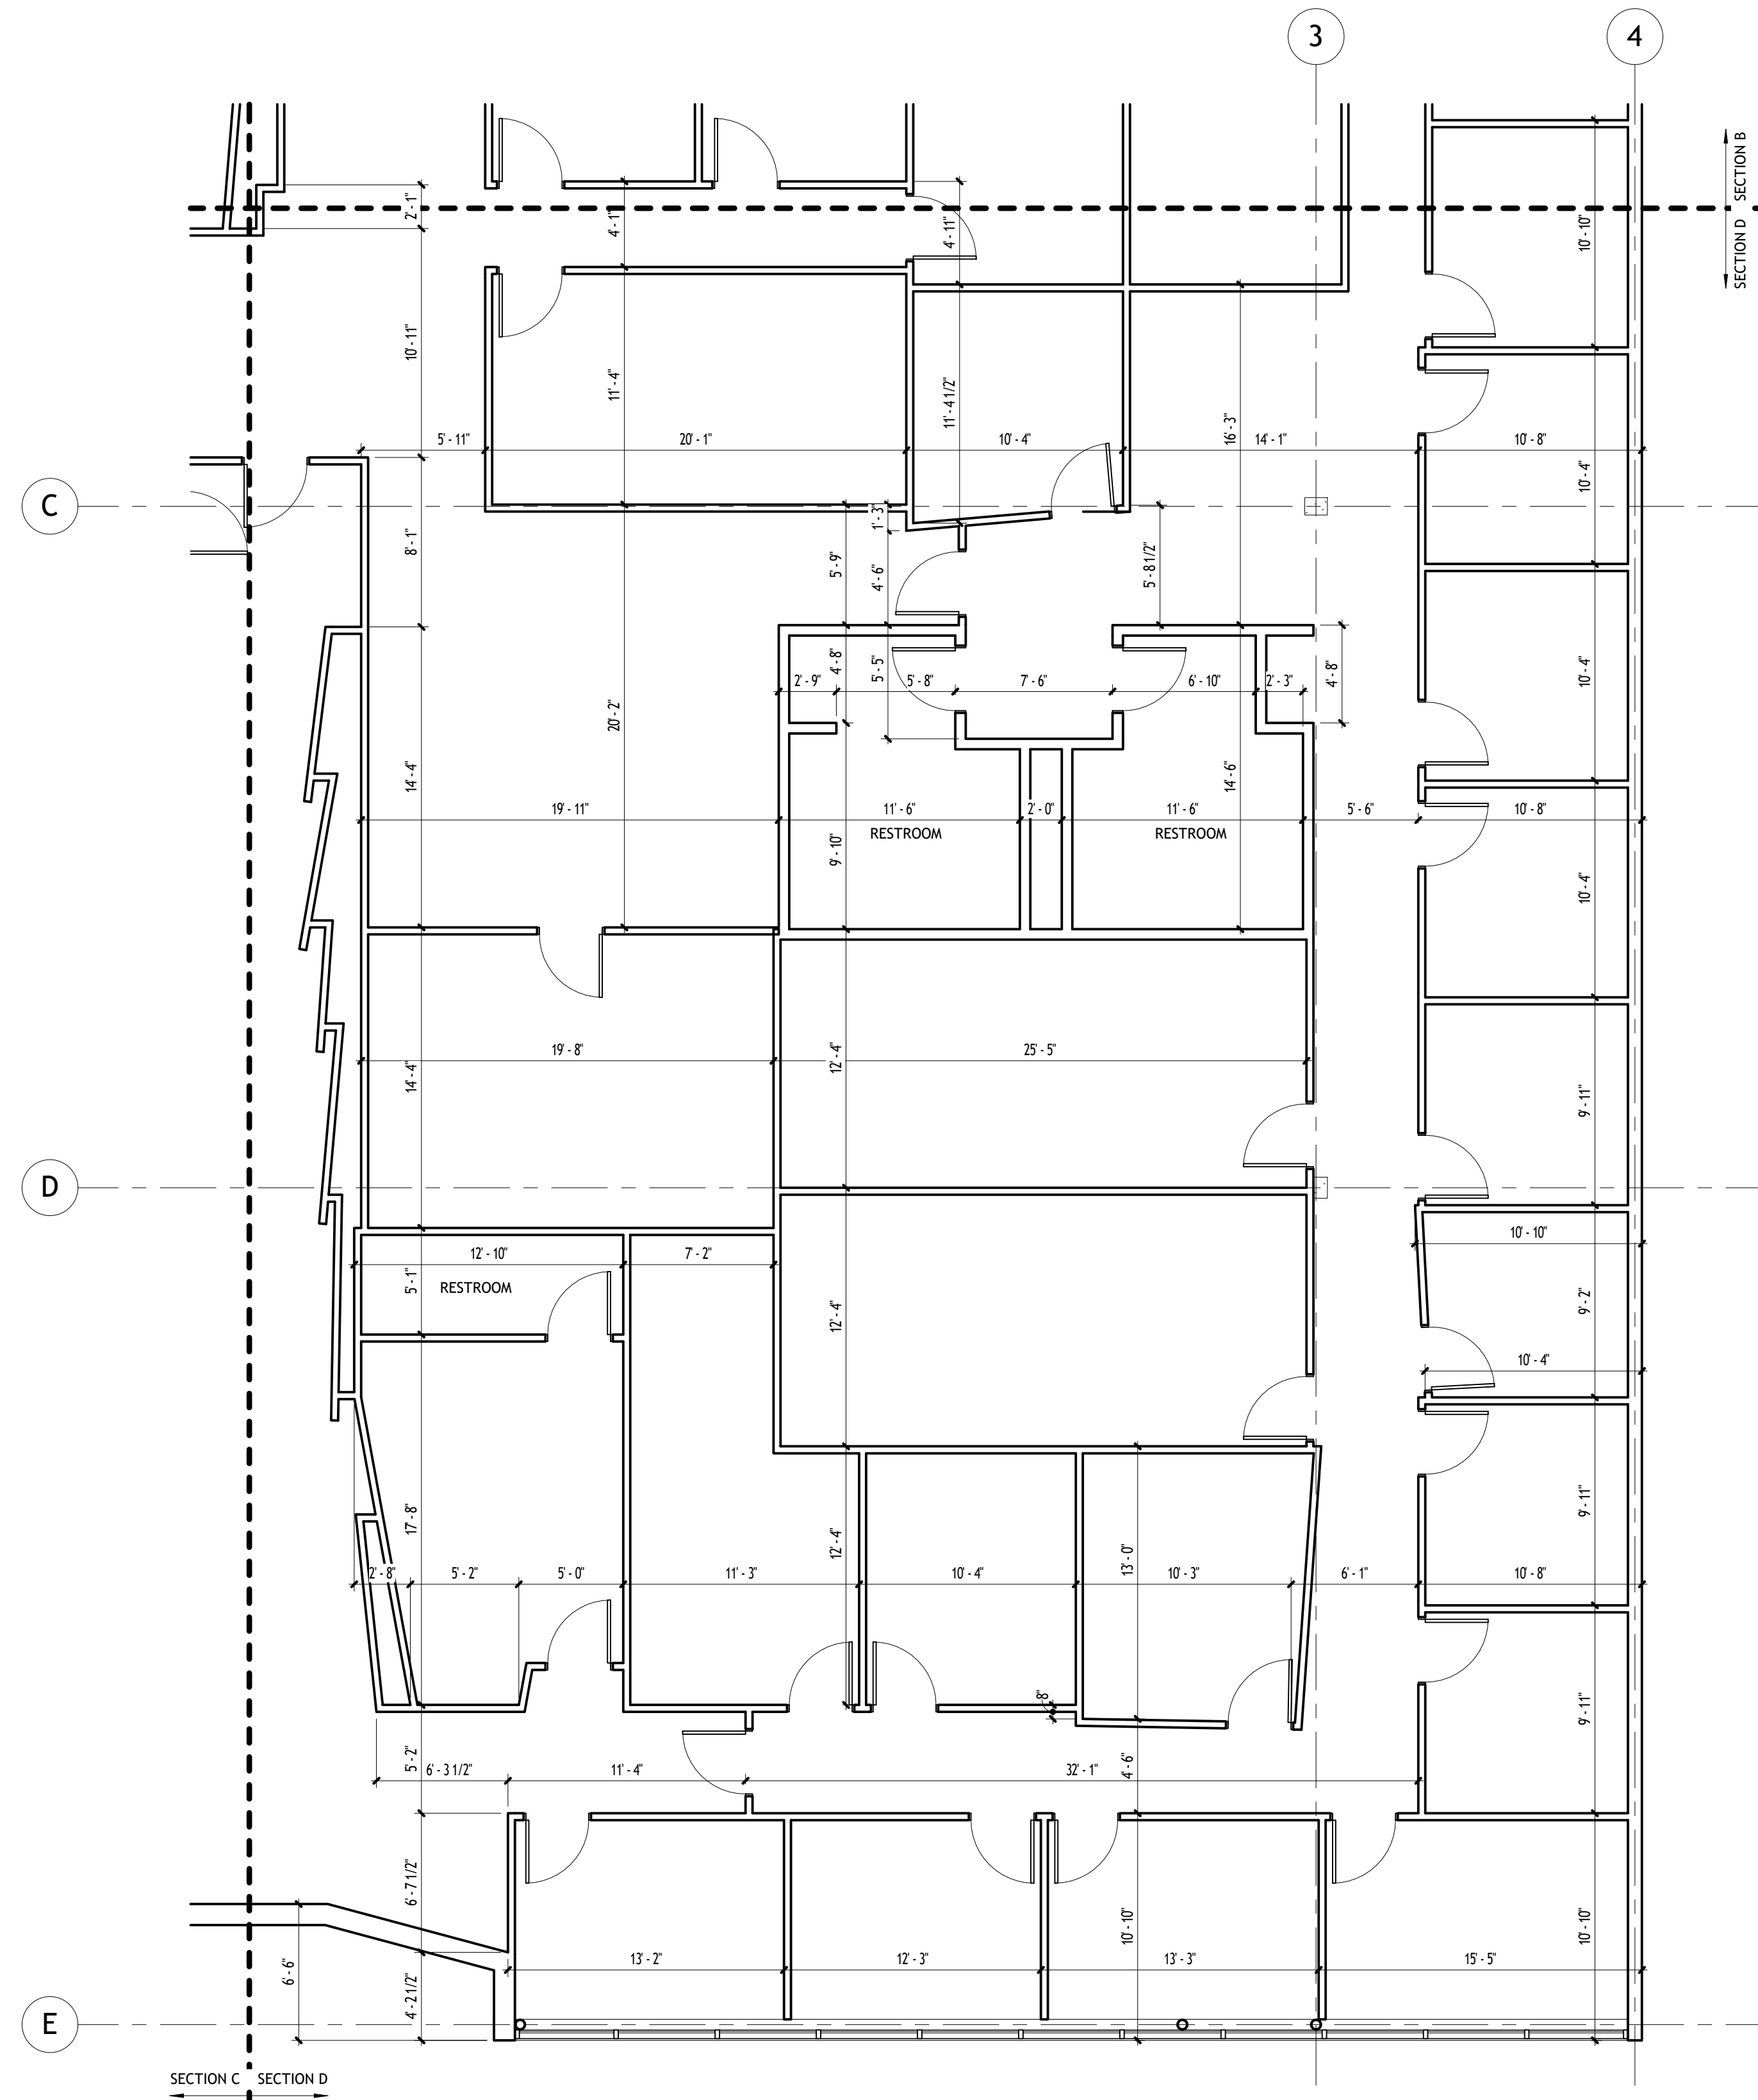

1 BUILDING 1ST FLOOR PLAN
3/16" = 1'-0"

GENERAL NOTES:
 - BUILDER TO REVIEW AND VERIFY ALL EXISTING CONDITIONS OF PROJECT DOCUMENTS. INCLUDING ALL EXISTING DIMENSIONS. IF DISCREPANCIES ARE DISCOVERED, OWNER MUST BE NOTIFIED PRIOR TO CONSTRUCTION EXECUTION.
 - CONTRACTOR TO EVALUATE AND INSPECT ALL EXISTING CONDITIONS AND BECOME FAMILIAR WITH THE EXISTING CONDITIONS PRIOR TO COMMENCEMENT OF CONSTRUCTION.

RIRI

RICHANIRINCON
ARCHITECTURE

BUILDING 1ST FLOOR PLAN - SECTION D

2921 SANFORD DRIVE SUITE 150

As Built
Drawings

Project Number	24-010
Date	Issue Date
Drawn By	MR
Checked By	MR

A1a4

Scale As indicated

RIRI

RICHANI & RINCON
ARCHITECTURE

BUILDING 1ST FLOOR PLAN - COLUMN GRID


2921 SANFORD DRIVE SUITE 150

As Built
Drawings

Project Number	24-010
Date	Issue Date
Drawn By	MR
Checked By	MR


A1b

Scale As indicated

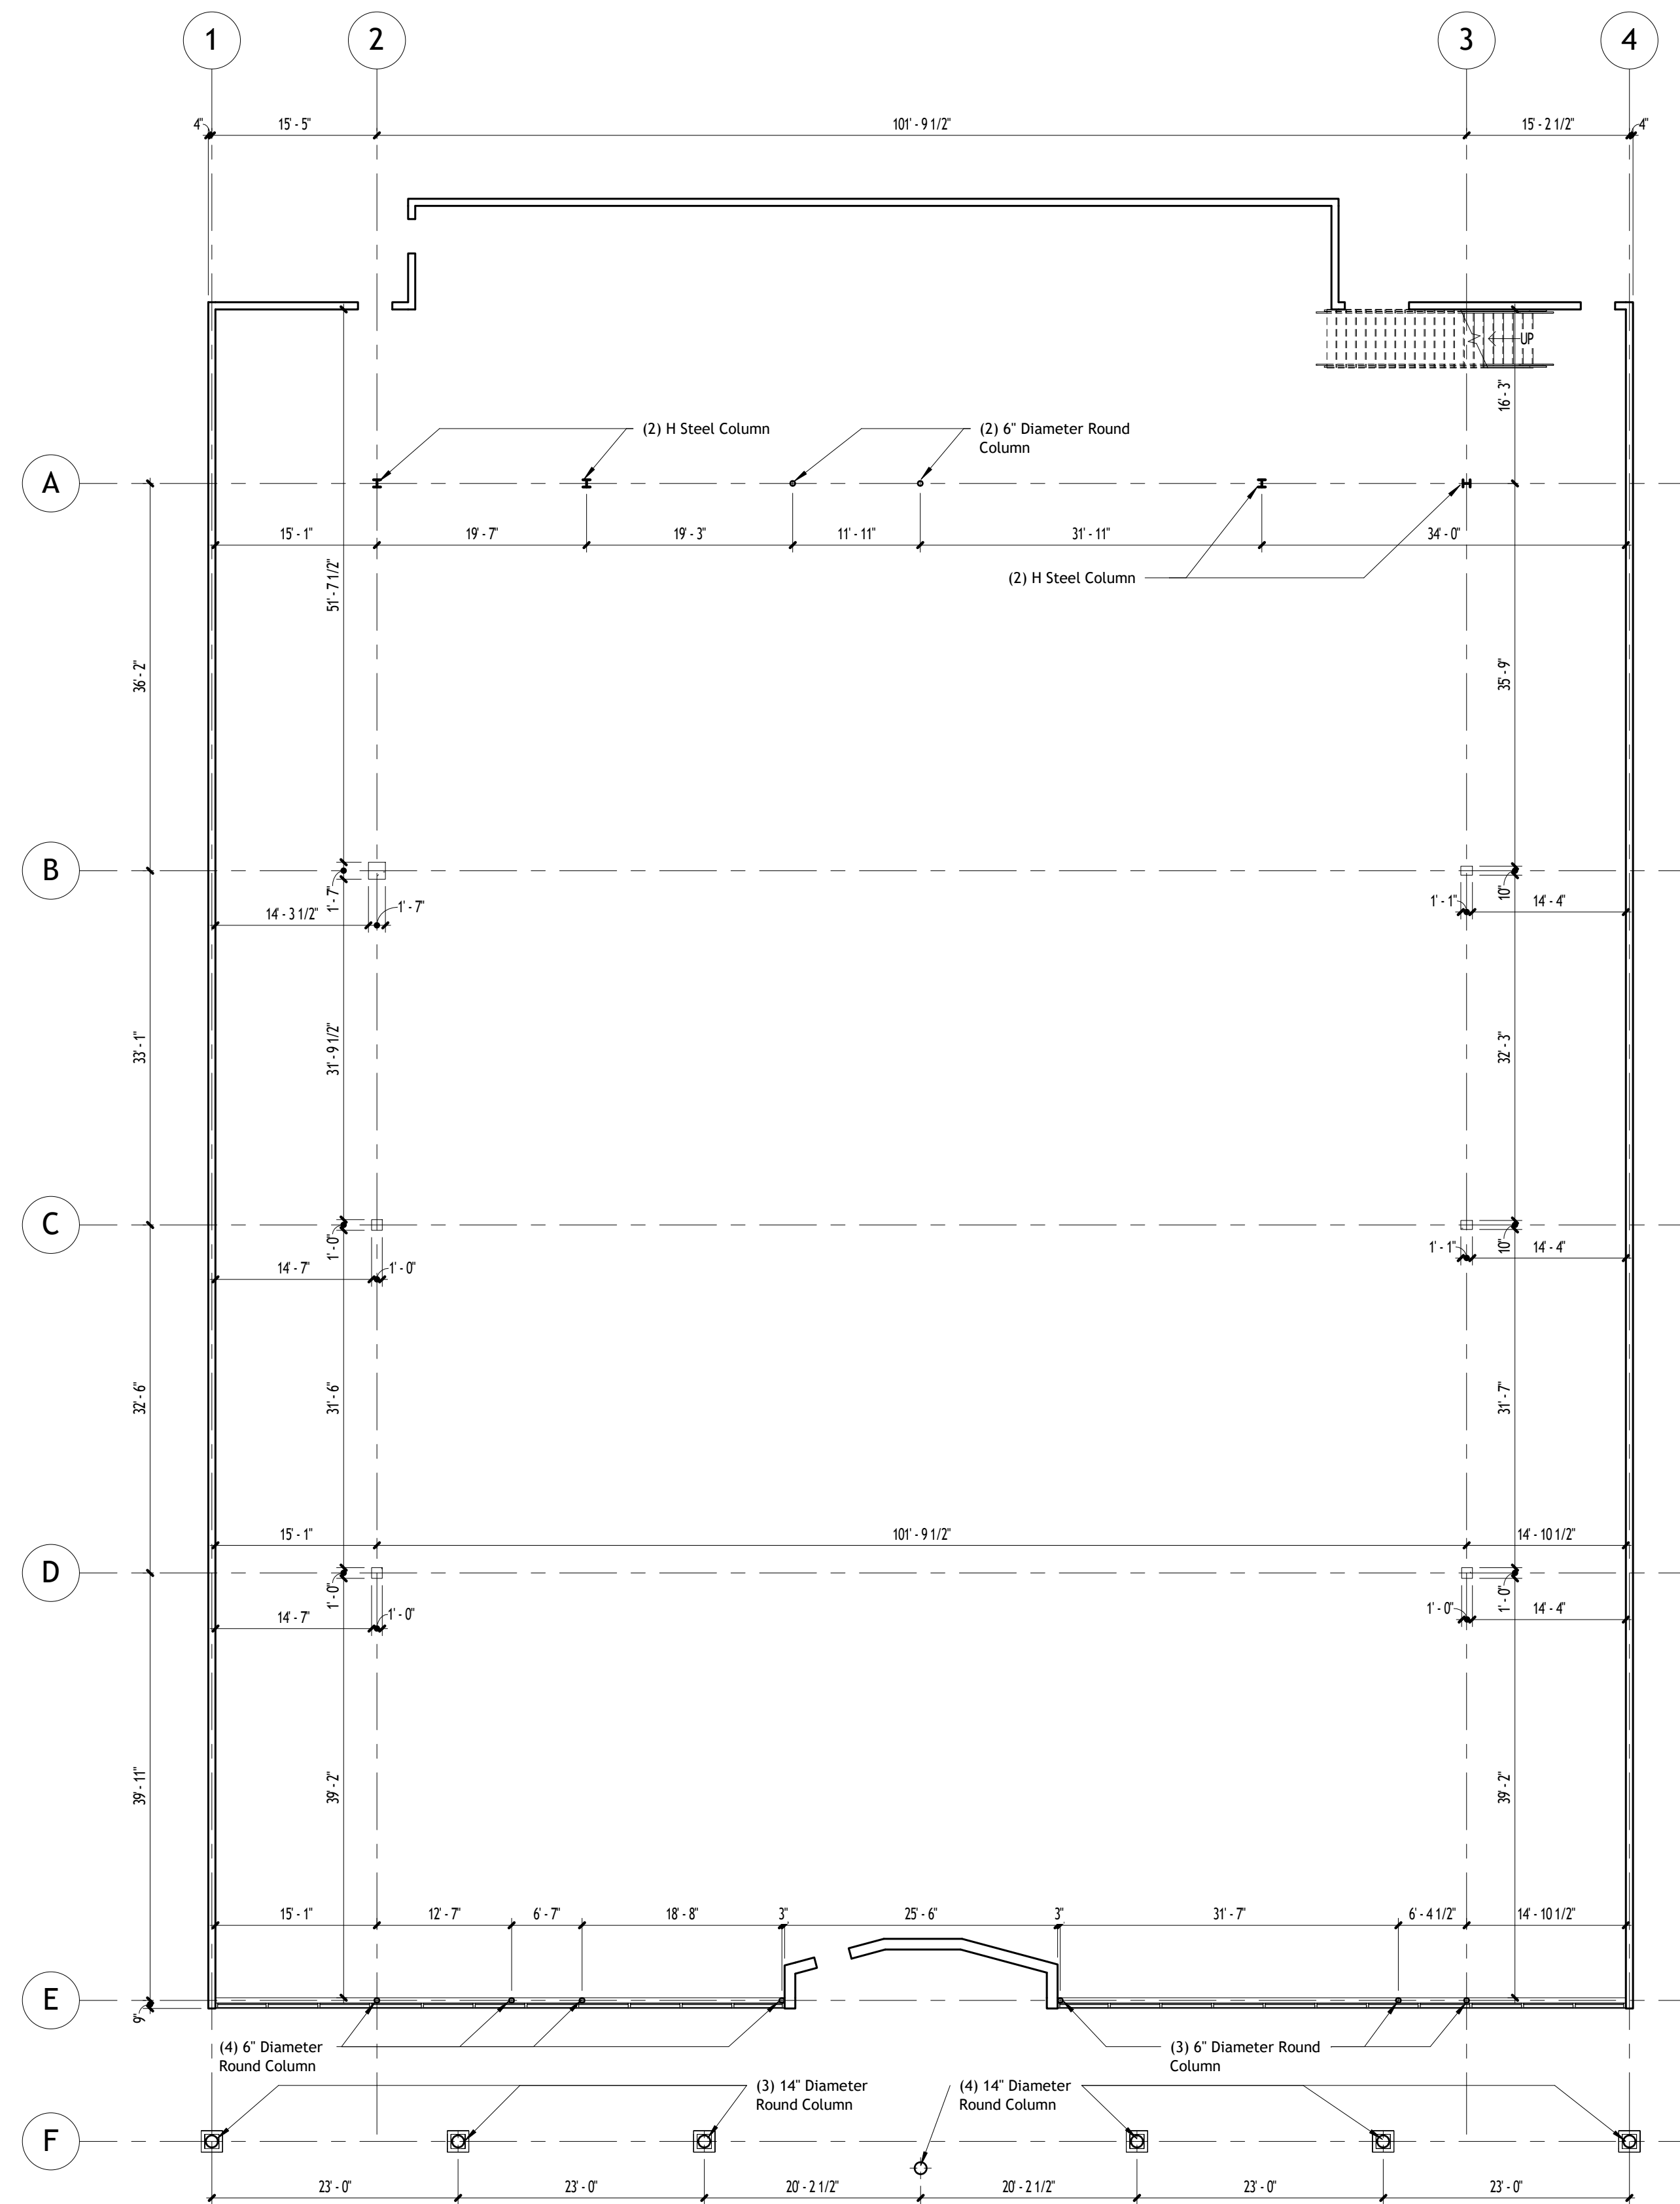

1 BUILDING 1ST FLOOR PLAN - COLUMN GRID
3/32" = 1'-0"

GENERAL NOTES:
- BUILDER TO REVIEW AND VERIFY ALL EXISTING CONDITIONS OF PROJECT DOCUMENTS, INCLUDING ALL EXISTING DIMENSIONS. IF DISCREPANCIES ARE DISCOVERED, OWNER MUST BE NOTIFIED PRIOR TO CONSTRUCTION EXECUTION.
- CONTRACTOR TO EVALUATE AND INSPECT ALL EXISTING CONDITIONS AND BECOME FAMILIAR WITH THE EXISTING CONDITIONS PRIOR TO COMMENCEMENT OF CONSTRUCTION.

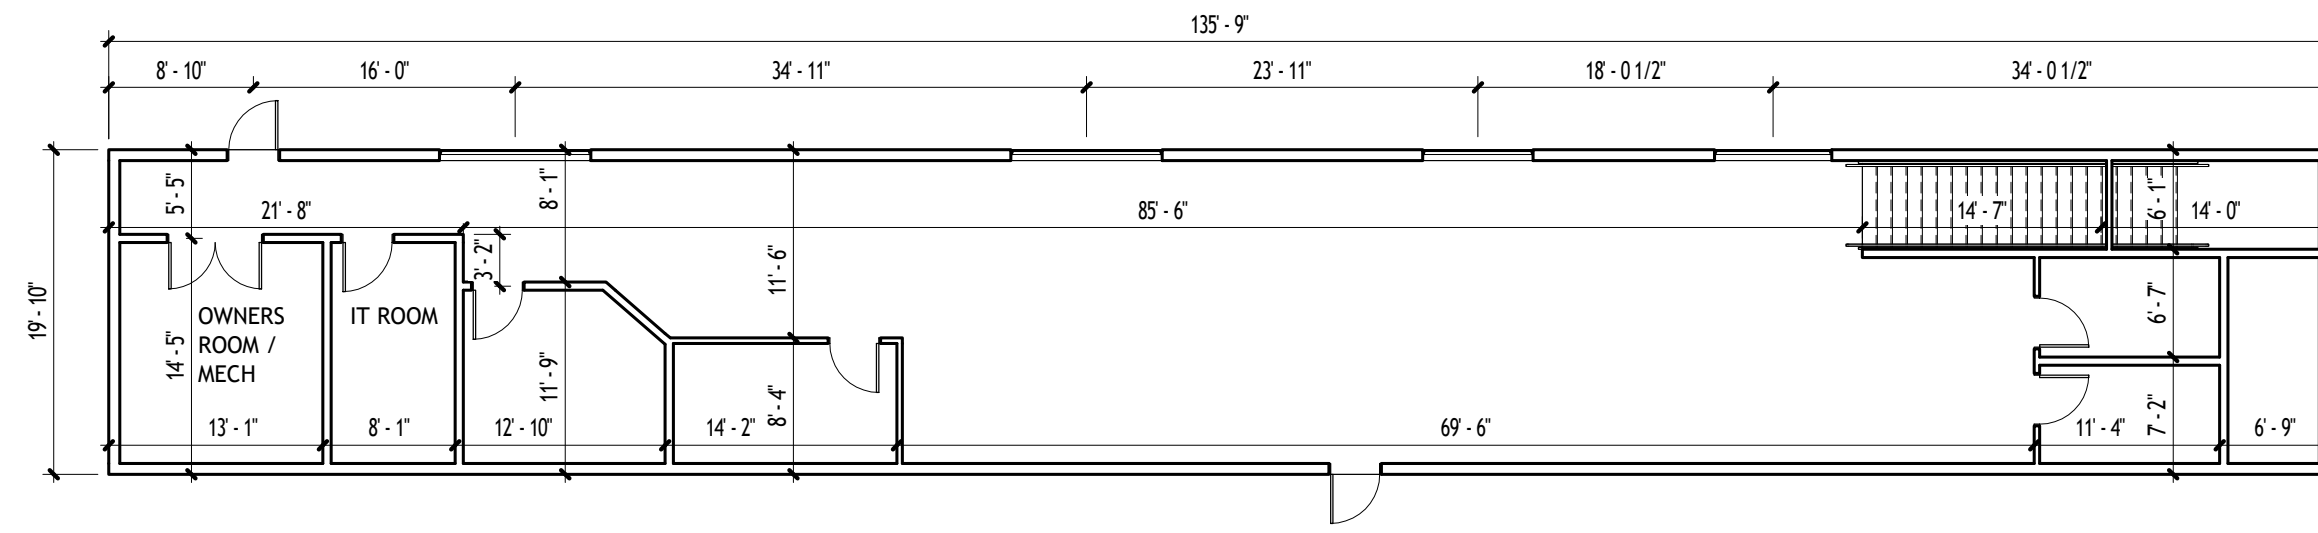

2 BUILDING 2ND FLOOR PLAN

3/32" = 1'-0"

RIRI

RICHANIRINCON
ARCHITECTURE

BUILDING 2ND FLOOR PLAN

2921 SANFORD DRIVE SUITE 150

**As Built
Drawings**

Project Number	24-010
Date	Issue Date
Drawn By	MR
Checked By	MR

A2a

Scale As indicated

GENERAL NOTES:
 - BUILDER TO REVIEW AND VERIFY ALL EXISTING CONDITIONS OF PROJECT DOCUMENTS, INCLUDING ALL EXISTING DIMENSIONS. IF DISCREPANCIES ARE DISCOVERED, OWNER MUST BE NOTIFIED PRIOR TO CONSTRUCTION EXECUTION.
 - CONTRACTOR TO EVALUATE AND INSPECT ALL EXISTING CONDITIONS AND BECOME FAMILIAR WITH THE EXISTING CONDITIONS PRIOR TO COMMENCEMENT OF CONSTRUCTION.