


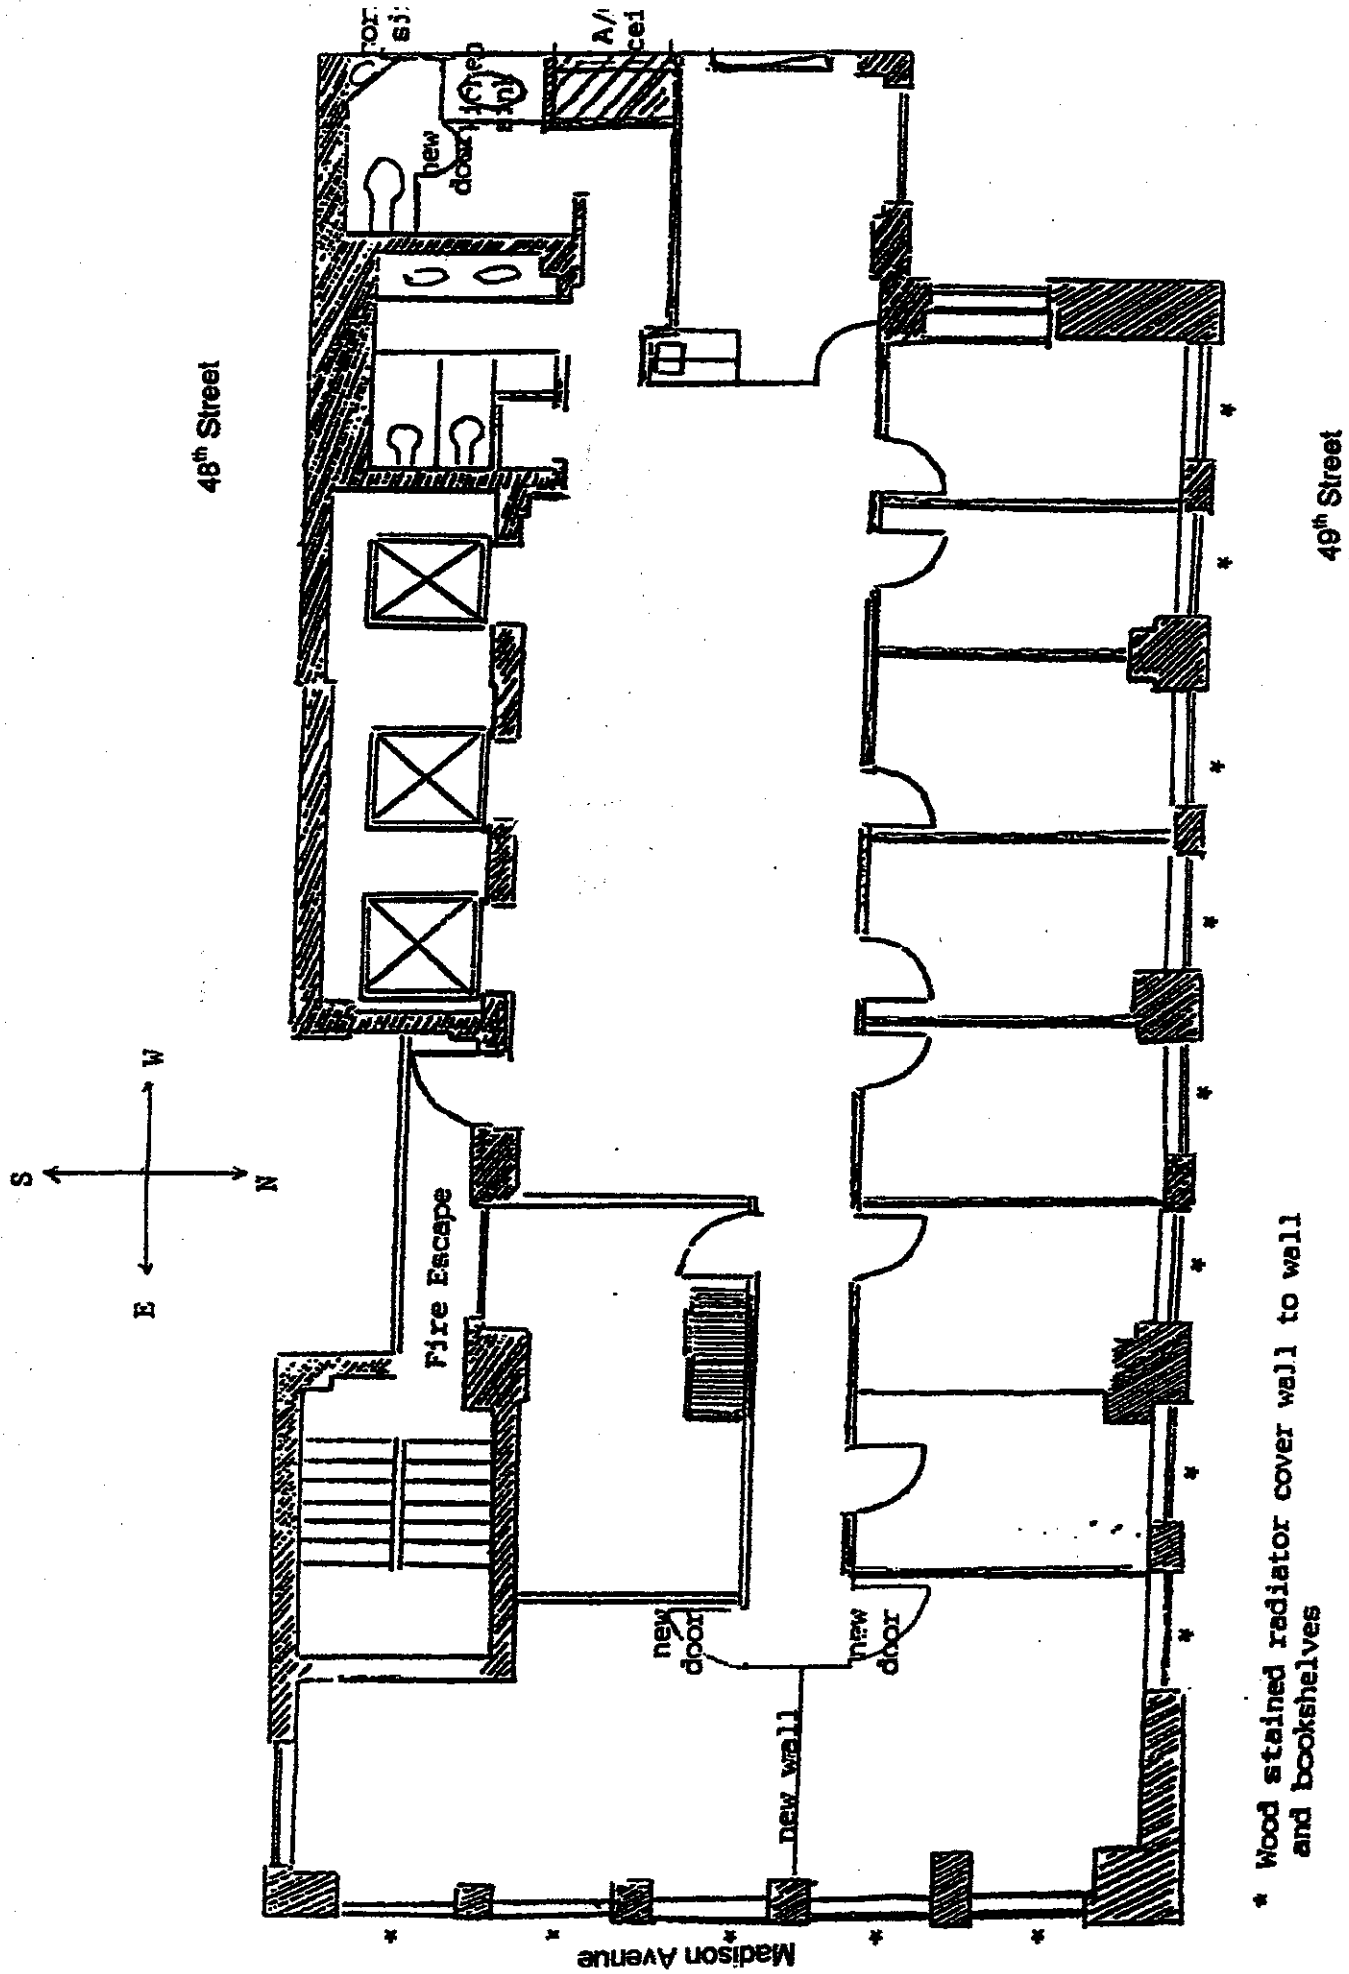

* Wood stained radiator cover wall to wall and bookshelves

SEVENTH FLOOR - 420 Madison Avenue