




AS-BUILT - 05.13.15

A3

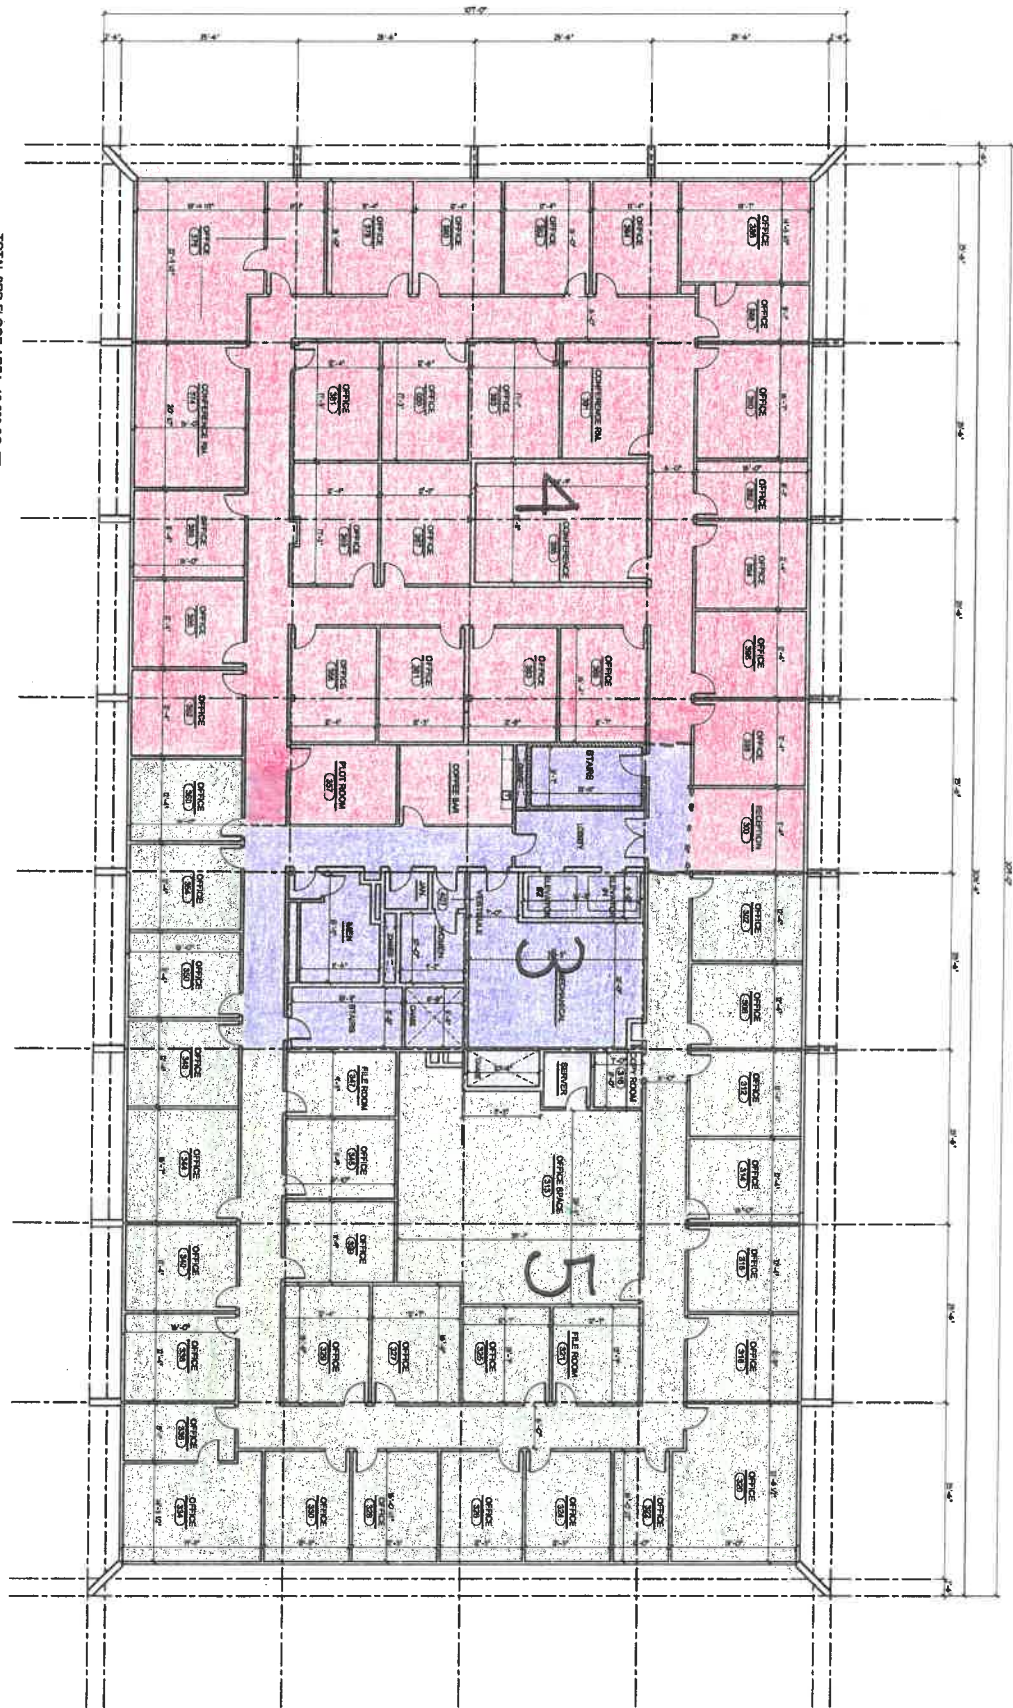

VICTOR J. PATINO, NCARB  
200 W. TEXAS AVE. # 1307  
DALLAS, TEXAS 75201  
TEL: 214-488-3448  
vjp@victorjpatino.com



VICTOR J. PATINO, NCARB  
200 W. TEXAS AVE. # 1307  
DALLAS, TEXAS 75201  
TEL: 214-488-3448  
vjp@victorjpatino.com



**Marathon Building**  
125 West Missouri, Midland TX