


R&D AT LEGACY

6400 PINECREST, PLANO, TX
SUITE 200 | 15,546 SF

AS-BUILT

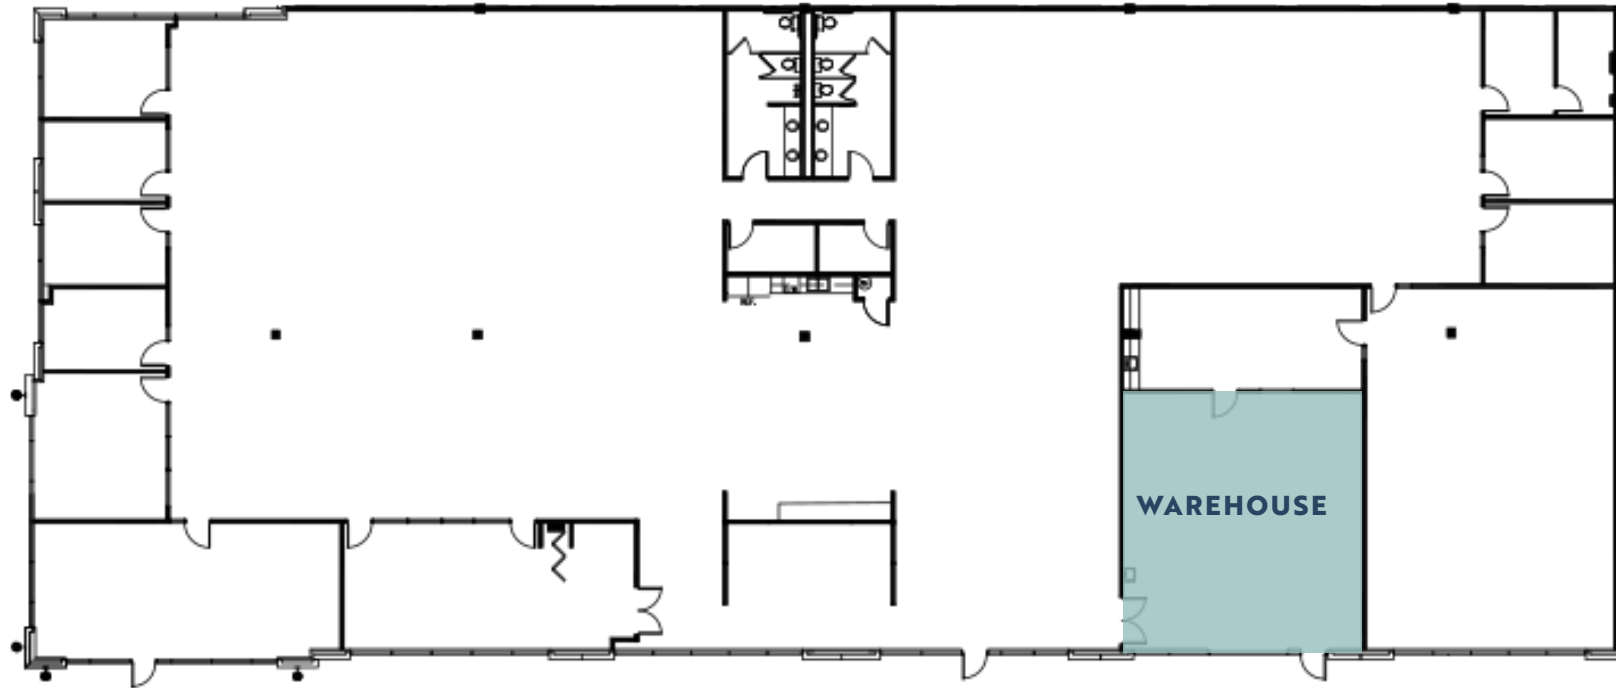

SUITE HIGHLIGHTS

Size: 15,546 SF Office: 90% Loading: Grade Level HVAC: 6 RTUs, 50 Tons Total



CHASE LOPEZ

214.267.0465

clopez@streamrealty.com

JAMES MANTZURANIS

214.267.0494

jmantzuranis@streamrealty.com

SAM BASS

214.210.1328

sam.bass@streamrealty.com

