


1

Reduced As-built

Suite 1109

Scale: 1/8" = 1'-0"

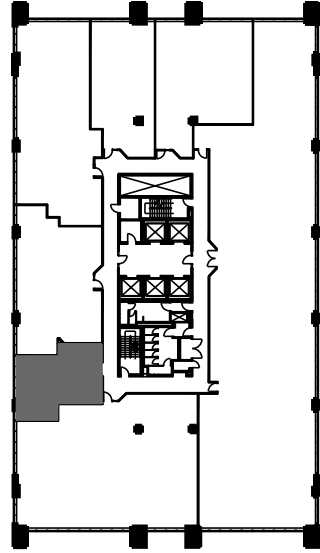

Proximity Plan

Suite 1109

The Chancery

901 RSF

The Chancery
Level Eleven; Suite 1109
1120 Lincoln Street
Denver, Colorado 80203



Reduced As-built Plan
Issued: March 2025
Drawn by: MCP / WCS
TPS Project #: 171001