

**CENTRAL
PHYSICIANS
PLAZA**


Floor 04

Suite 402

AS-BUILT

4,277 SF

AVAILABLE

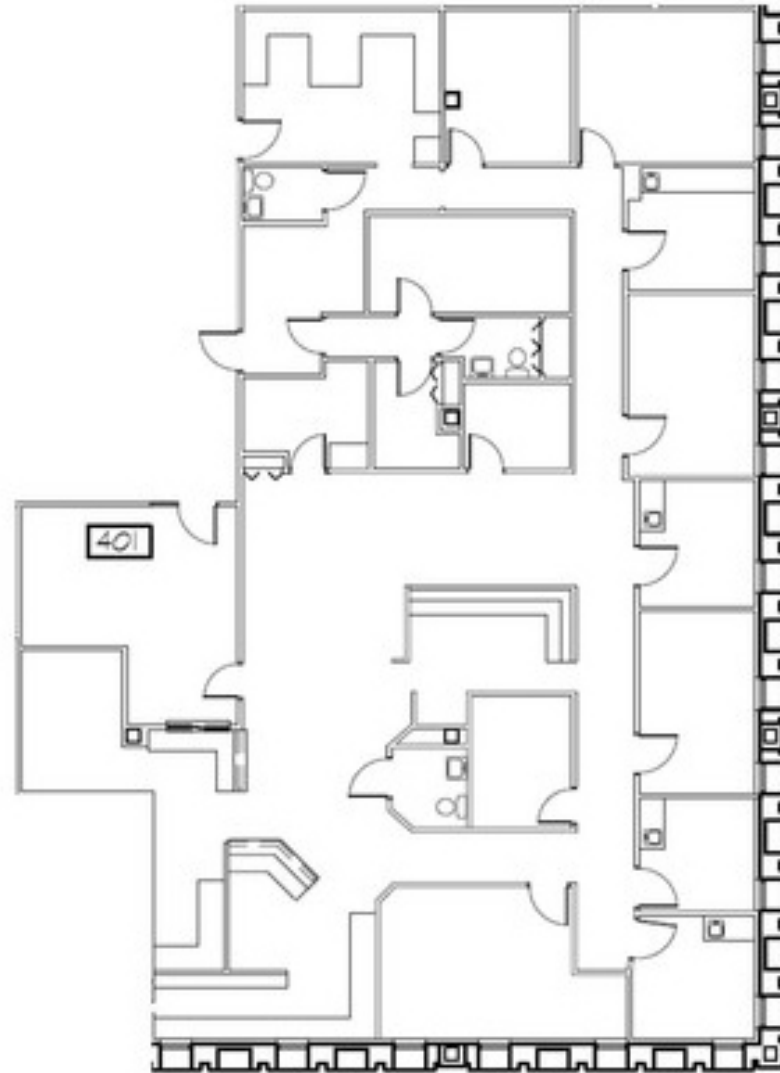

RACHAEL THOMPSON
Senior Vice President
602.513.5122
rachael.thompson@kidder.com

PERRY GABUZZI, CCIM
Senior Vice President
602.513.5116
perry.gabuzzi@kidder.com