
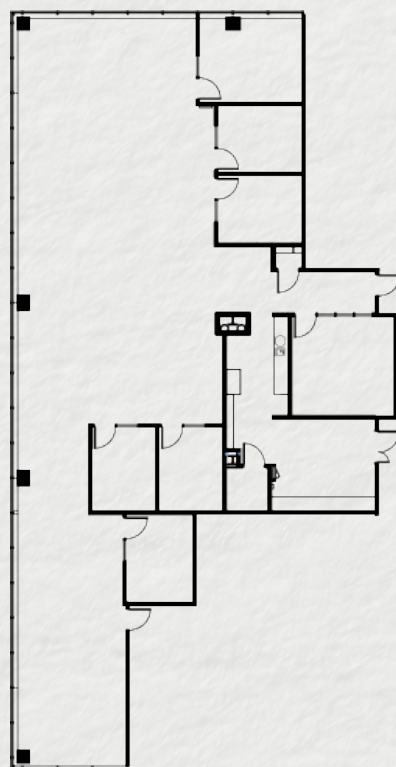


9400
W. HIGGINS

4,878 SF

SUITE 220

AS-BUILT CONDITIONS

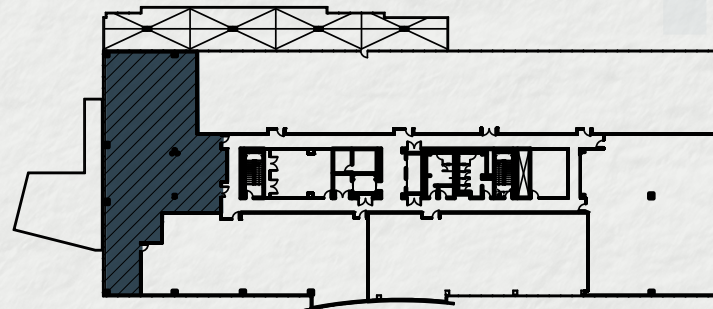

ROSEMONT, ILLINOIS, 60018

NINETY-FOUR HUNDRED HIGGINS ROAD

JOSH CRANE
SENIOR DIRECTOR
+1 312 424 8151
JOSH.CRANE@CUSHWAKE.COM

AAOS
AMERICAN ACADEMY OF
ORTHOPAEDIC SURGEONS

 **CUSHMAN &
WAKEFIELD**