


Property Key

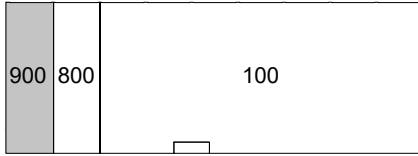

WMGSA Roosevelt As Built Marketing Package

10901-11001 Roosevelt Boulevard and 1000 112th Circle, St. Petersburg, FL 33716

Building: 2D

Suite: 2D-900

Sheet: A-3

Scale: Not to Scale
Sheet Size: 8.5" x 11"
Not For Construction




BAY SPACE

Total Area - 2,110 SF

Building Information

DECK HEIGHT:	14'-9"
CEILING HEIGHT:	8'-6"
CLEAR HEIGHT:	14'-2"
SPRINKLERED:	No

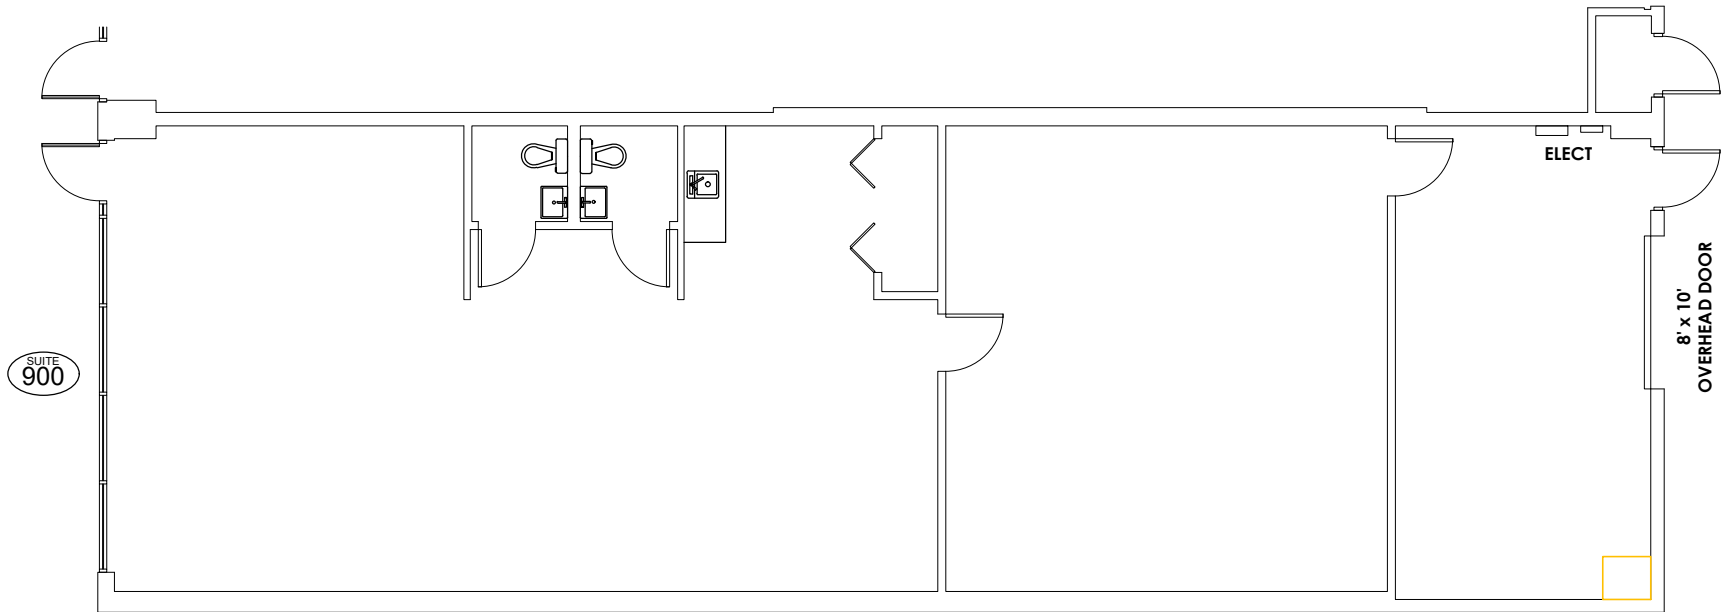

As Built Floor Plan for Marketing

