
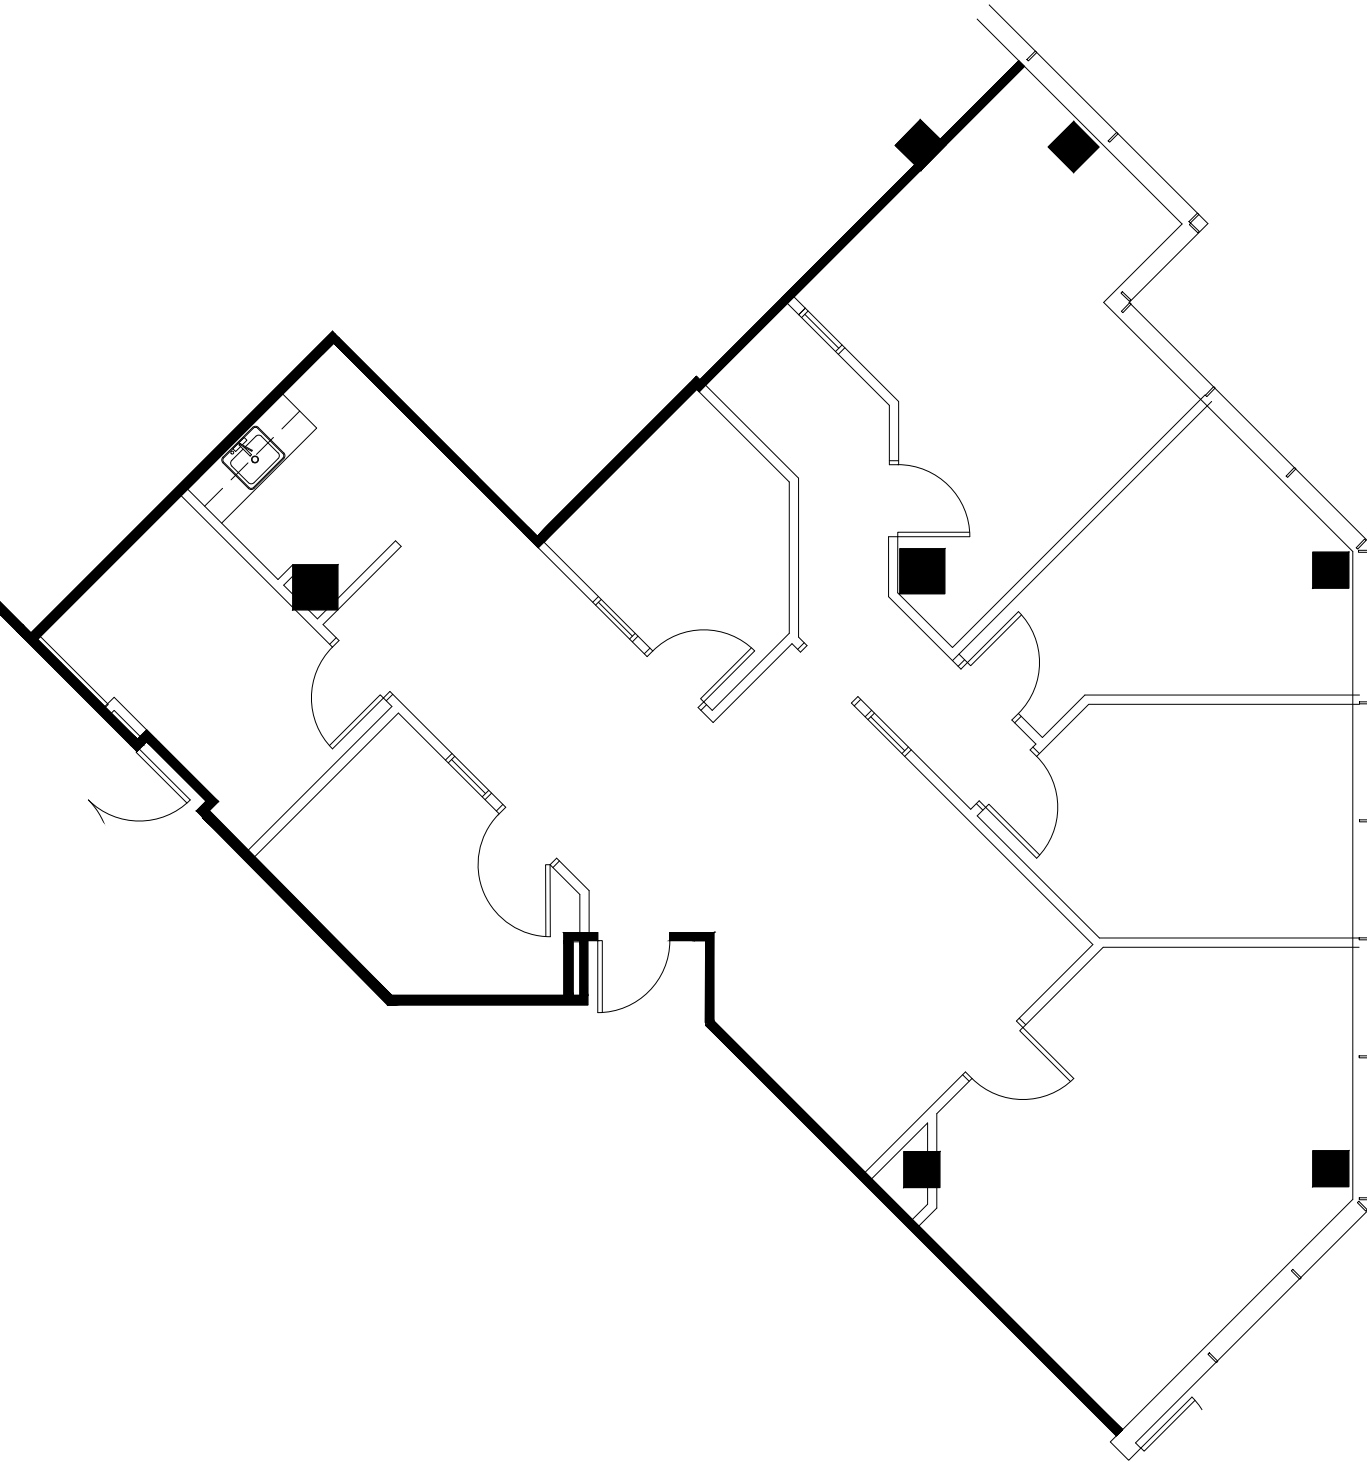


THE EXCHANGE

5200 // SUITE 160 // 1,913 RSF

AS BUILT - 1 OF 1
SCALE: 1/8" = 1'-0"
DATE: APRIL 29, 2025

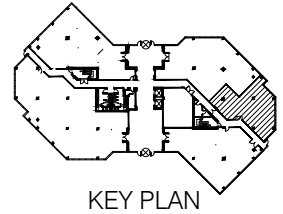

CBRE



**SMITH
HARRIS**
DESIGN
associates