



8211 W Broward Blvd
Plantation, FL 33324

Suite 210
6,115 SF As Built


Alfie Hamilton

Senior Vice President
+1 954 652 4615
alfie.hamilton@colliers.com

Colliers International
Florida, LLC
200 E Broward Boulevard
Suite 1150
Fort Lauderdale, FL 33301
P: +1 954 652 4600
colliers.com




Flagstar Bank Building

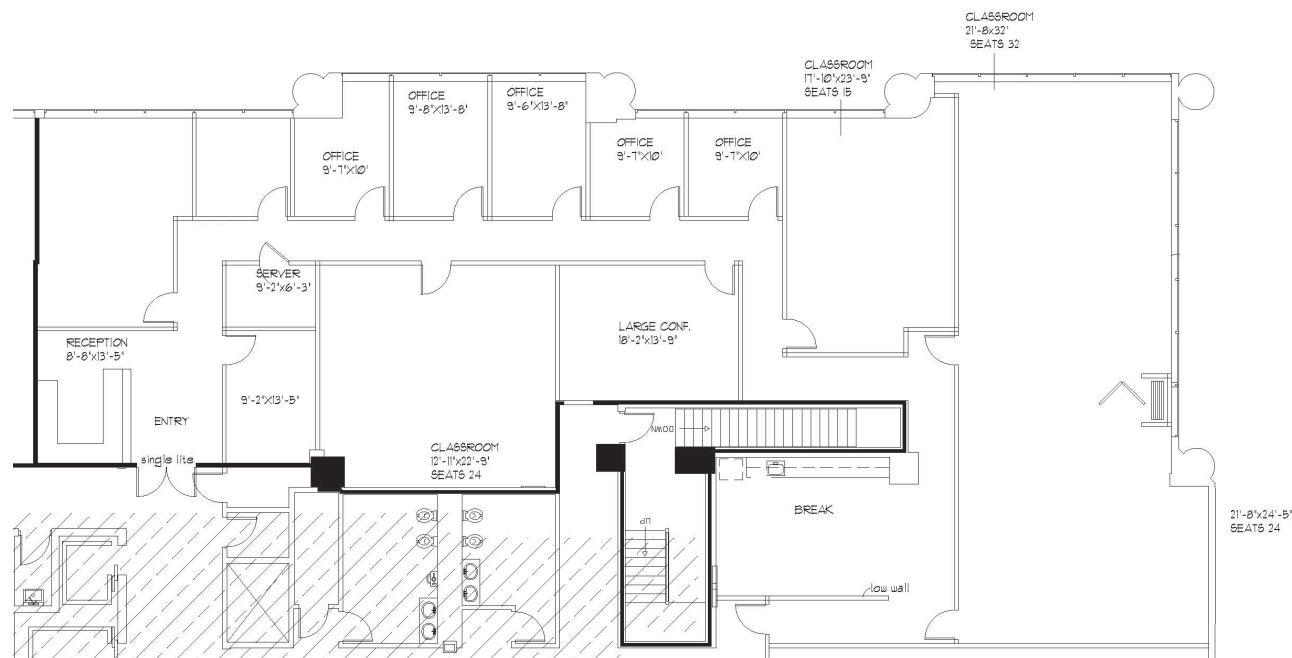

Suite Features

- Glass double door entry from elevator lobby
- Formal reception
- Two conference rooms off of reception
- Six offices on the window-line
- Four large existing classrooms which can easily be used for different business units or converted to open office
- Large breakroom
- Server / Storage Room

Second Floor Overview

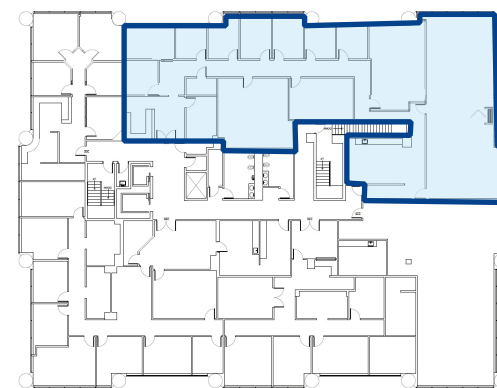

All information is furnished from sources deemed reliable. No warranty or representation is made as to the accuracy thereof and it is submitted subject to errors, omissions, change of price, rental or other conditions, prior sale, lease, financing or withdrawal without notice.