

GROUND FLOOR PLAN




PROJECT: **S.E.C. 43rd AVE. & LOWER BUCKEYE RD**
 4215 W. LOWER BUCKEYE RD. & 2821 S. 43rd AVENUE PHOENIX, AZ 85009

PROJECT NO: 2412-00
 DATE: 4-16-2024
 REVISED:
 DRAWN BY: JT

SHEET
 OF

COLUMN SPACING / DIMENSIONS

AS-BUILT

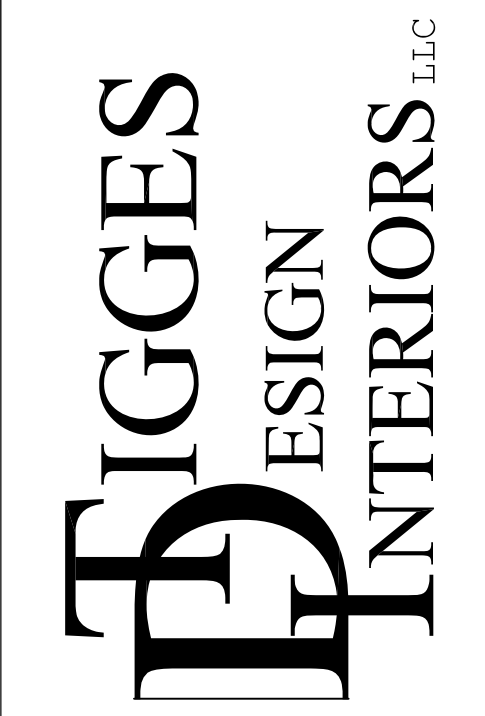

PHOENIX, AZ 85032 PH: (602) 228-6871 FAX: (602) 595-2925