

11 GRAND CENTRAL EAST

PARTIAL FLOOR 17
 SUITE 1725
 10,964 SF



BUILDING EXTERIOR



BUILDING LOBBY



TERRACE


AVAILABILITY

- Exposed Brick and Ceilings
- Premium Built Space
- Arranged Possession

PROPERTY FEATURES

- New windows and perimeter induction units promote tenant comfort and energy efficiency
- Select floors feature green roofs and private terraces
- LEED GOLD Certification under LEEDv4 Existing Building: Operations and Maintenance
- Block and a half from Grand Central Terminal

AS-BUILT PLAN

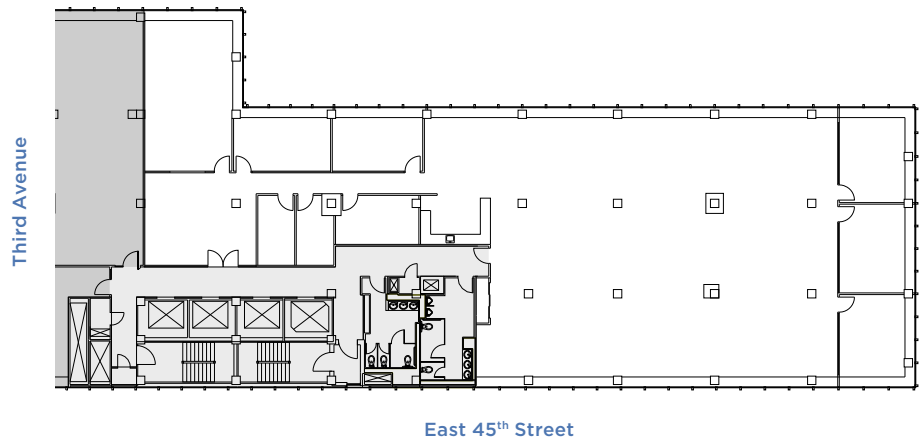

LEASING CONTACTS

Karen Rose
 212.257.6596
 KRose@durst.org

Bailey Caliban
 212.257.6535
 BCaliban@durst.org

Sayo Kamara
 212.789.1761
 SKamara@durst.org

Eric Engelhardt
 212.257.6620
 EEngelhardt@durst.org