



American Building Calculations

3853 Northdale Blvd
Suite 253
Tampa, FL 33624
813-600-5472
www.abcalc.biz

FAIRMOUNT PARTNERS LLC

Client:
C/O Just Rentals LLC
811 US Hwy 27 S
Sebring FL 33870
863-381-4025


Property:
Fairmount Cinema Sq
3750-1E US Hwy 27 N
Sebring, FL 33870

This is an unpublished existing condition measurement / as-built floor plan document created by American Building Calculations, Inc. Any site plans are outlines only and are not to be considered valid engineering drawings. This document has been created based on the contract for this project agreed upon between the owner and American Building Calculations, Inc. Any publication, copying, distribution or exhibiting of this document with attributes identifying American Building Calculations, Inc. is not permitted in any fashion without the written permission of American Building Calculations, Inc.

Field Drawn By:	JM
Drawn By:	JM
Published Date:	05/12/23
Revision Date:	N/A

Scale:	
CUSTOM	

FIRST FLOOR
FLOOR PLAN

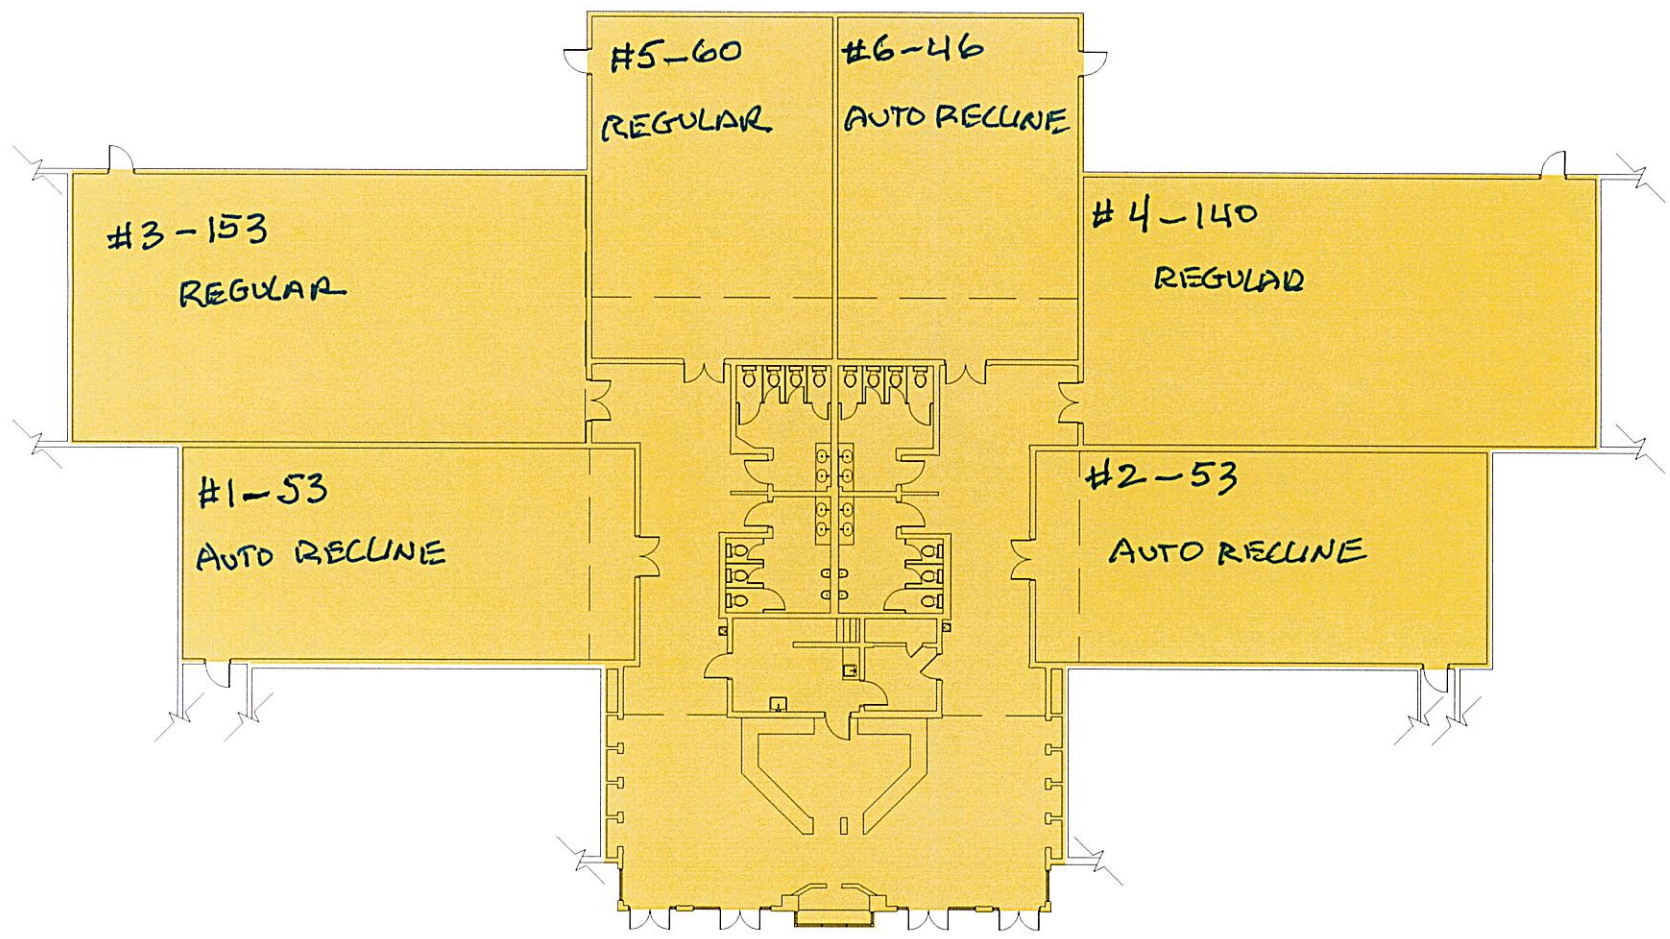

GROSS LEASABLE AREA - 14,122.71 SF

