

BOSWELL WEST MEDICAL OFFICE BUILDING


Floor 01

Suite 106

AS-BUILT

612 SF

AVAILABLE

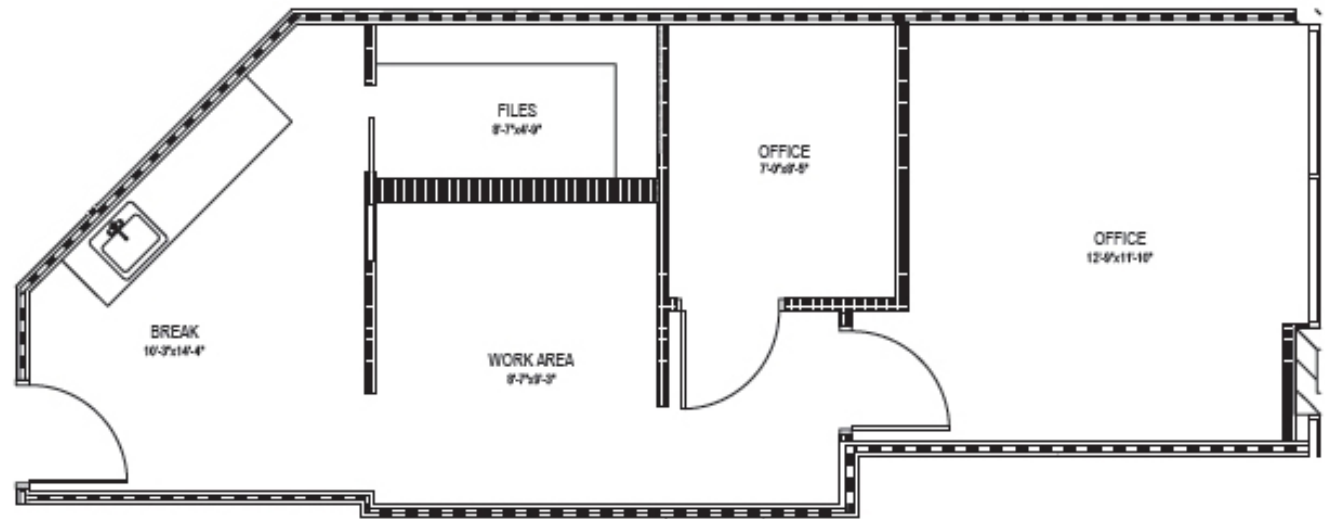

RACHAEL THOMPSON
Senior Vice President
602.513.5122
rachael.thompson@kidder.com

PERRY GABUZZI, CCIM
Senior Vice President
602.513.5116
perry.gabuzzi@kidder.com