

CHATHAM COUNTY HEALTH DEPARTMENT

Water Supply and Sewage Disposal
IMPROVEMENTS PERMIT

SPRING
CHARLY

Lot
Block
Map

No. 11070

Date 7-9-76

Owner: _____

Location: 19501 RD (R) RUSSET HILL
1570 HOME OWN

Contractor: _____

Water Supply: Private Public _____

No. Bedrooms 2 Other _____

Daily Flow Rate _____ Application Rate _____

AN INSPECTION TO ADD 5th ROOM
SCARRED PORCH & DECK

Size of tank: _____ Nitrification line: SYSTEM

APPEARED TO FUNCTIONING PROPERLY
AT TIME OF INSPECTION

Water supply and sewage disposal facilities location, installation and protection must meet state and local regulations.

Septic tank should be pumped out every 3 to 5 years and shall be maintained by owner in such a manner as not to create a public health hazard. Septic tank and nitrification line MUST BE INSPECTED AND APPROVED BY A MEMBER OF THE HEALTH DEPARTMENT STAFF BEFORE ANY PORTION OF THE INSTALLATION IS COVERED AND PUT INTO USE.

ORIG PERMIT
UNDER
TAZELAR

Signed _____
Sanitarian

Counter-
signed _____
(Owner or his representative)

This permit is subject to revocation if site plans or the intended use change. This permit for sewage disposal is valid for 5 years.

Certificate of Completion

Date Approved: 7-9-76 By: [Signature]
Sanitarian


(OVER)

Location of well and sewage disposal facilities sketched on back.



NOTE: Make sketch of installation showing lot size and shape, location of house, septic tanks, privies, water supplies, etc. Note special problems existing on lot. Write in measurements in order that installations may be located at later date. Note location of water supplies on adjacent lots.

(1)

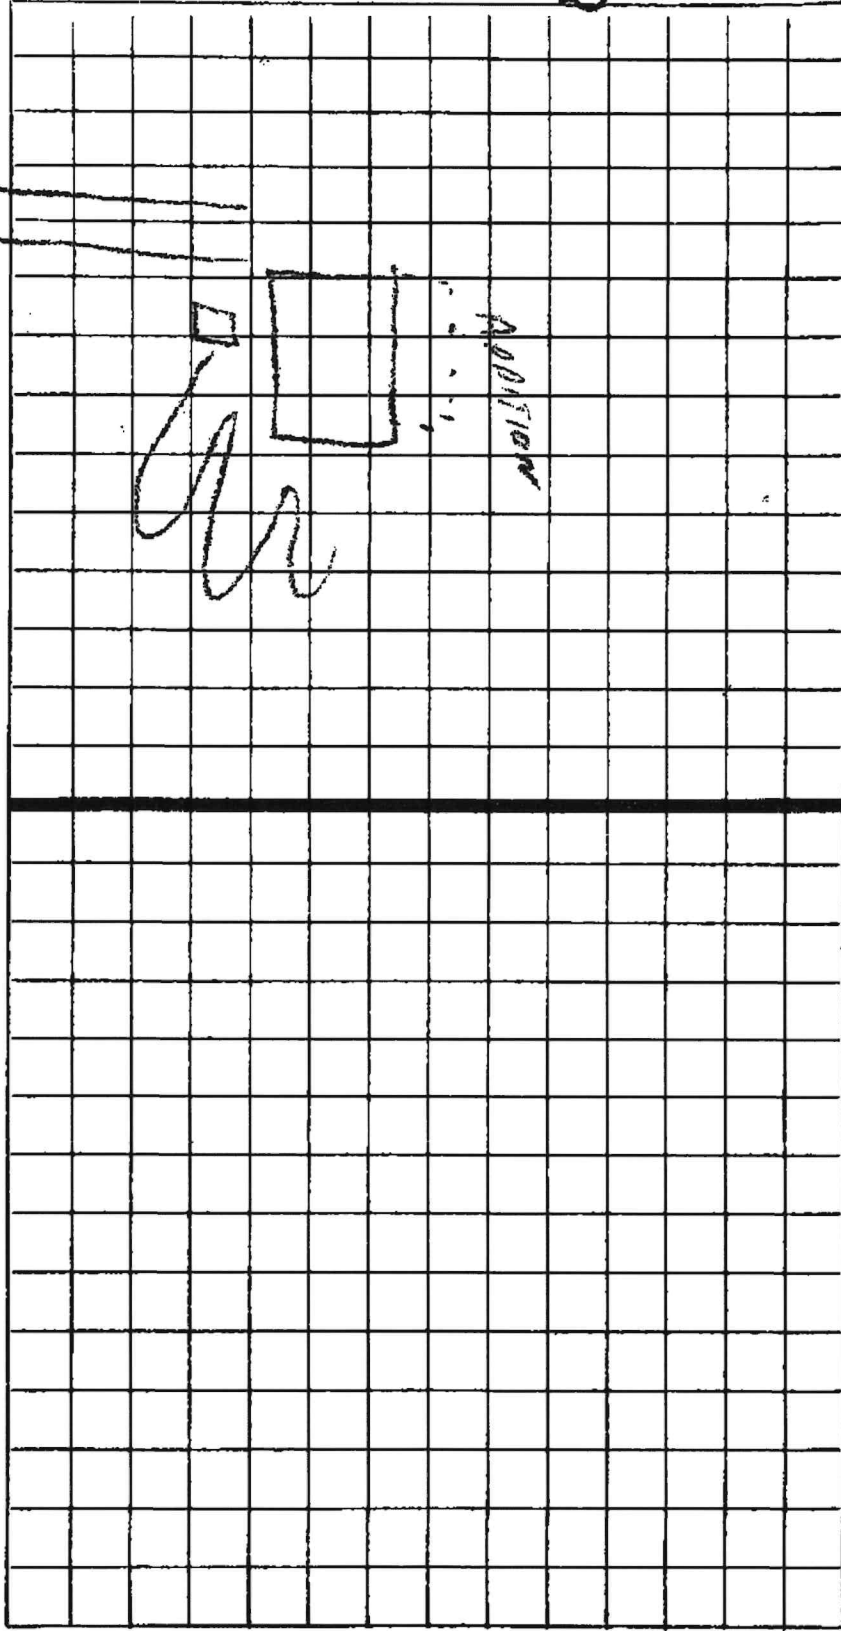

Water Supply and Sewage Disposal IMPROVEMENTS PERMIT

No. J.C. 30

Date 10-30-91

Owner: JOHN FAZELAR

Location: Access from Northward School

Map Lot Block
When road is completed from pavement to ground
to the right. Drive was 800 ft down from right
Contract: before now banks by left.

Water Supply: Private Existing Public

No. Bedrooms 3 Other _____

Daily Flow Rate 360 Application Rate 0.3

Size of tank: 1000 Nitrification line: 400' x 3' x 34"

Water supply and sewage disposal facilities location, installation and protection must meet state and local regulations.

Septic tank should be pumped out every 3 to 5 years and shall be maintained by owner in such a manner as not to create a public health hazard. Septic tank and nitrification line **MUST BE INSPECTED AND APPROVED BY A MEMBER OF THE HEALTH DEPARTMENT STAFF BEFORE ANY PORTION OF THE INSTALLATION IS COVERED AND PUT INTO USE.**

Signed [Signature] Sanitarian

Counter signed _____ (Owner or his representative)


This permit is subject to revocation if site plans or the intended use change. This permit for sewage disposal is valid for 5 years.

Date Approved: 12/20/91 By: [Signature] Sanitarian

Certificate of Completion

(OVER) Location of well and sewage disposal facilities sketched on back.

Make sketch of installation showing lot size and shape, location of house, septic tanks, privies, water supplies, etc. Note special problems existing on lot. Write in measurements in order that installations may be located at later date. Note location of water supplies on adjacent lots.

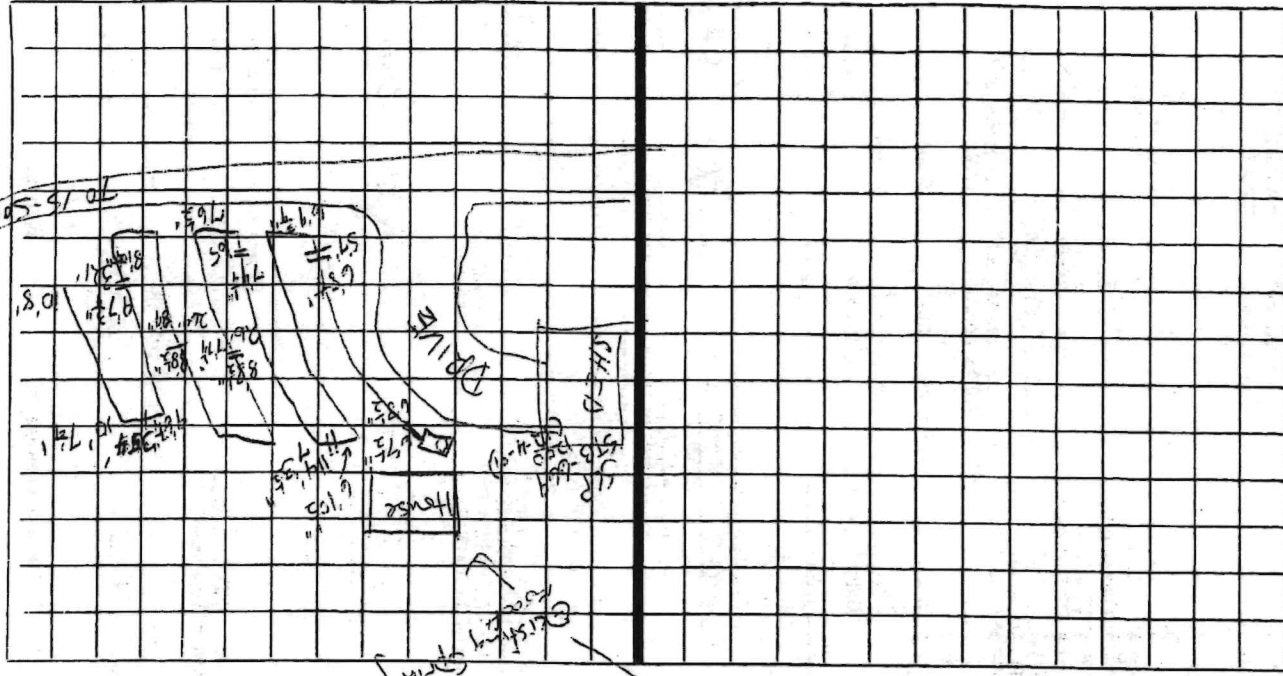

(2)