

Note: All dimensions are approximate and should be field verified.


Eave Height: 28'+/-

2,066+/- S.F. L1 Office
 2,819+/- S.F. Mezz. Office
 18,714+/- S.F. Warehouse
 23,599+/- S.F. TOTAL


2324 S. Sam Houston Pkwy W. Houston, TX	DATE:	ISSUE/REVISION:	DRAWING: A1
	04/18/2025	AS-BUILT	
HarryGendelArchitects	JOB#:	TITLE:	
	FILE:	AS-BUILT FLOOR PLAN	



LEVEL ONE - OFFICE PLAN

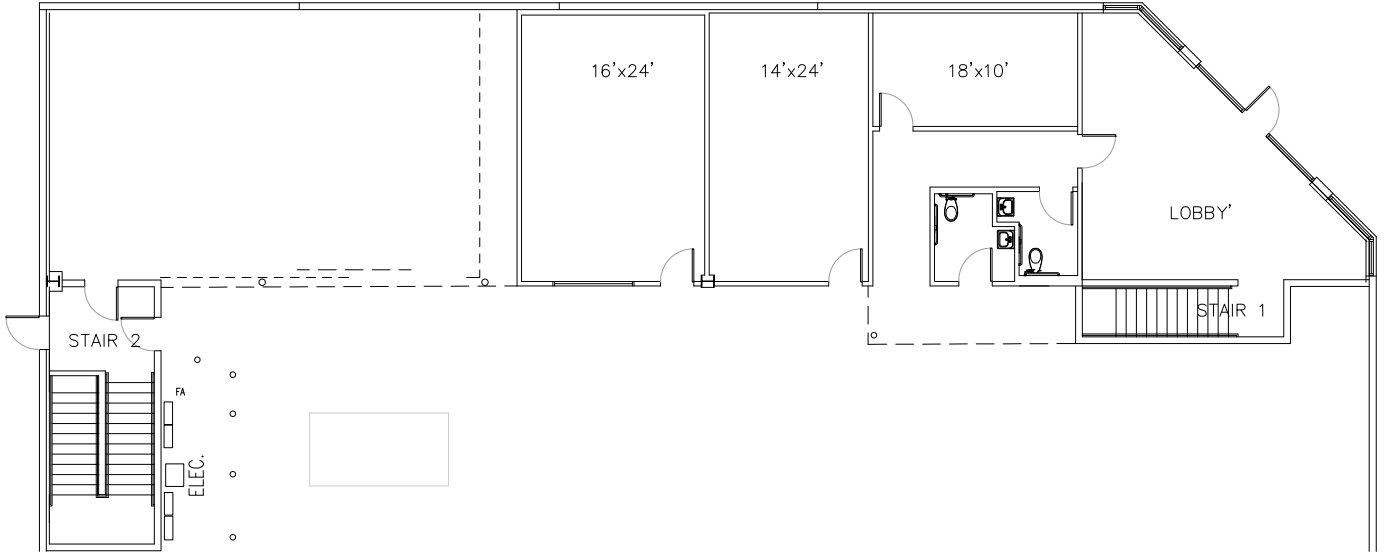

MEZZANINE - OFFICE PLAN

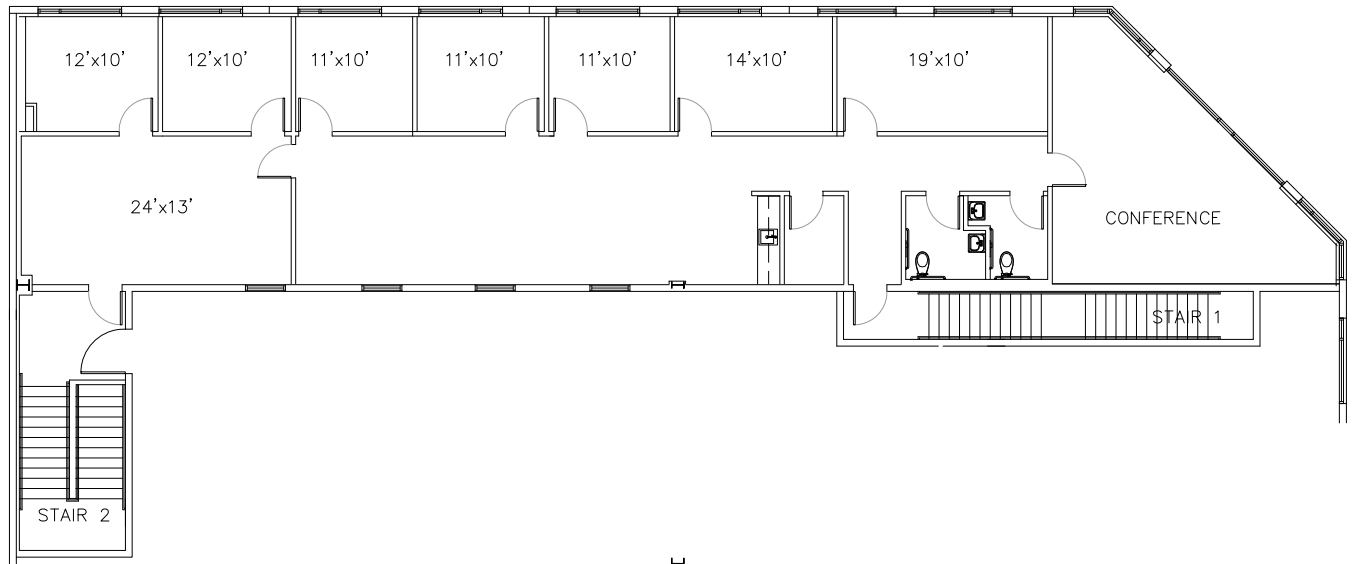

Note: All dimensions are approximate and rounded to the nearest foot and should be field verified.

Eave Height: 28'+/-

2,066+/- S.F. L1 Office
 2,819+/- S.F. Mezz. Office
 18,714+/- S.F. Warehouse
 23,599+/- S.F. TOTAL

2324 S. Sam Houston Pkwy W.
 Houston, TX

HarryGendelArchitects



DATE:	ISSUE/REVISION:	DRAWING: A2
04/18/2025	AS-BUILT	
JOB#:	TITLE:	
FILE:	ENLARGED PLANS	