


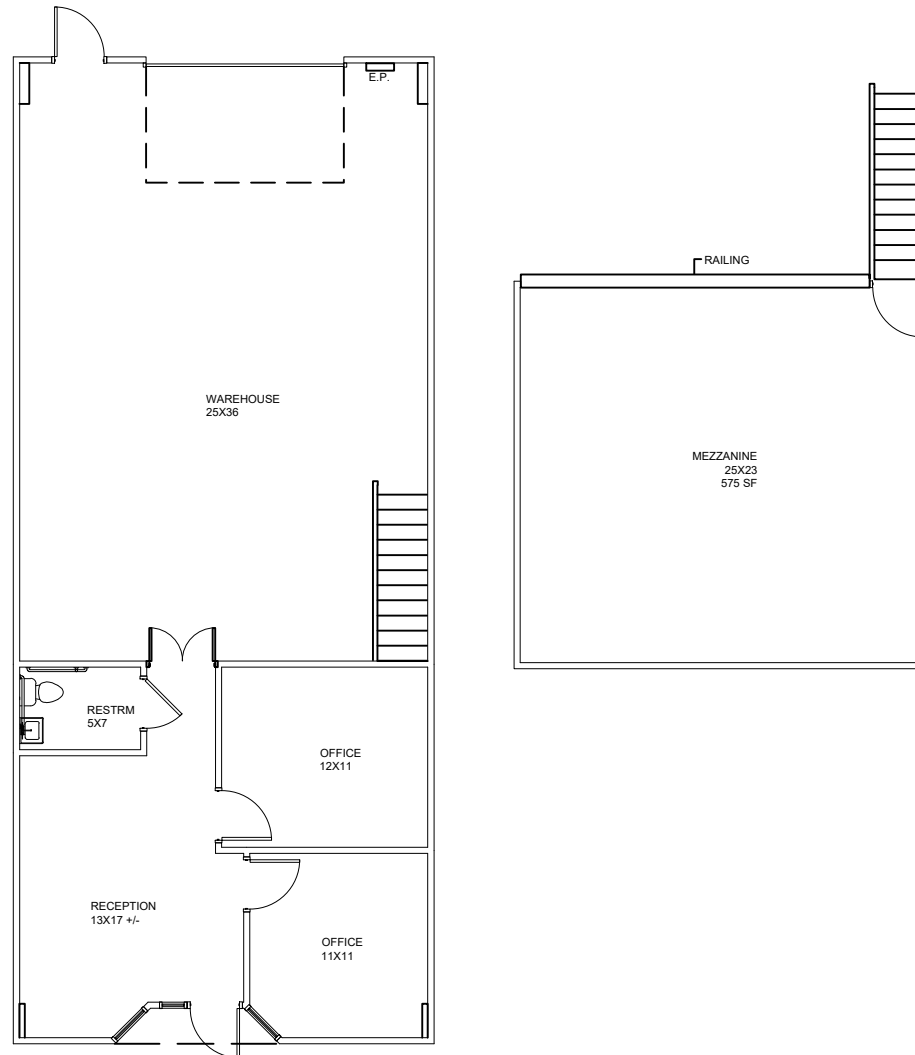

SUITE A-6--2,075 RSF

SCALE: N.T.S.

AS-BUILT PLAN

6820 MEADOWRIDGE COURT
ALPHARETTA, GA 30005

5.08.23

ARCHITECTURAL DESIGN INNOVATIONS

ADI, Inc.