


KEY PLAN

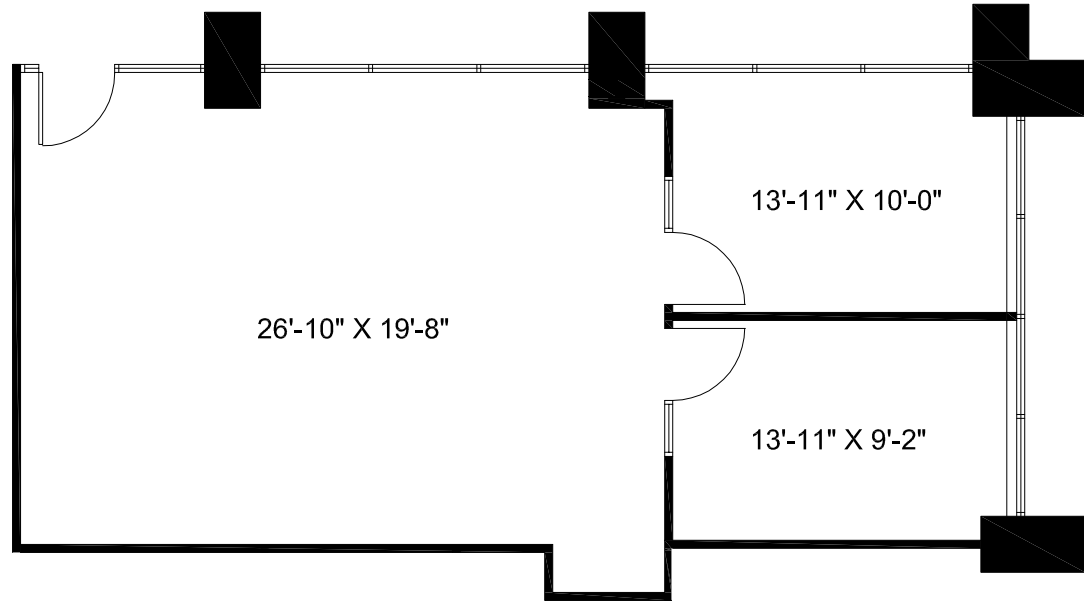

TOLL HILL WEST

5310 HARVEST HILL
DALLAS, TEXAS 75230

AS-BUILT PLAN
SUITE 192

rsf:	1,001
scale:	1/8" = 1'-0"
date:	12.03.15



208 north market street
suite 420
dallas, texas 75202
214.420.4646

CAWLEY PARTNERS
REAL ESTATE INVESTORS

ADDIE LUDWIG
(972) 759-7727

JEREMY DUGGINS
(972) 759-7716