

RSF = 1977 SF

HOT WATER TANK
 ABOVE SINK

CLIENT:
 Rosebriar Properties

PROJECT:
 As-Builts

ADDRESS:
 1221 Flower Mound R.
 Flower Mound, TX
 75028

Date 11/4/20
 Drawn by J.Browns
 Scale 3/16" = 1'-0"

Floor Plan

SHEET:
A1

1 1a- 1st Flr
 3/16" = 1'-0"

CLIENT:
 Rosebriar Properties


PROJECT:
 As-Builts

ADDRESS:
 1221 Flower Mound R.
 Flower Mound, TX
 75028

Date 11/4/20
 Drawn by J.Browns
 Scale 3/16" = 1'-0"

**Reflected
 Ceiling Plan**

SHEET:
A2

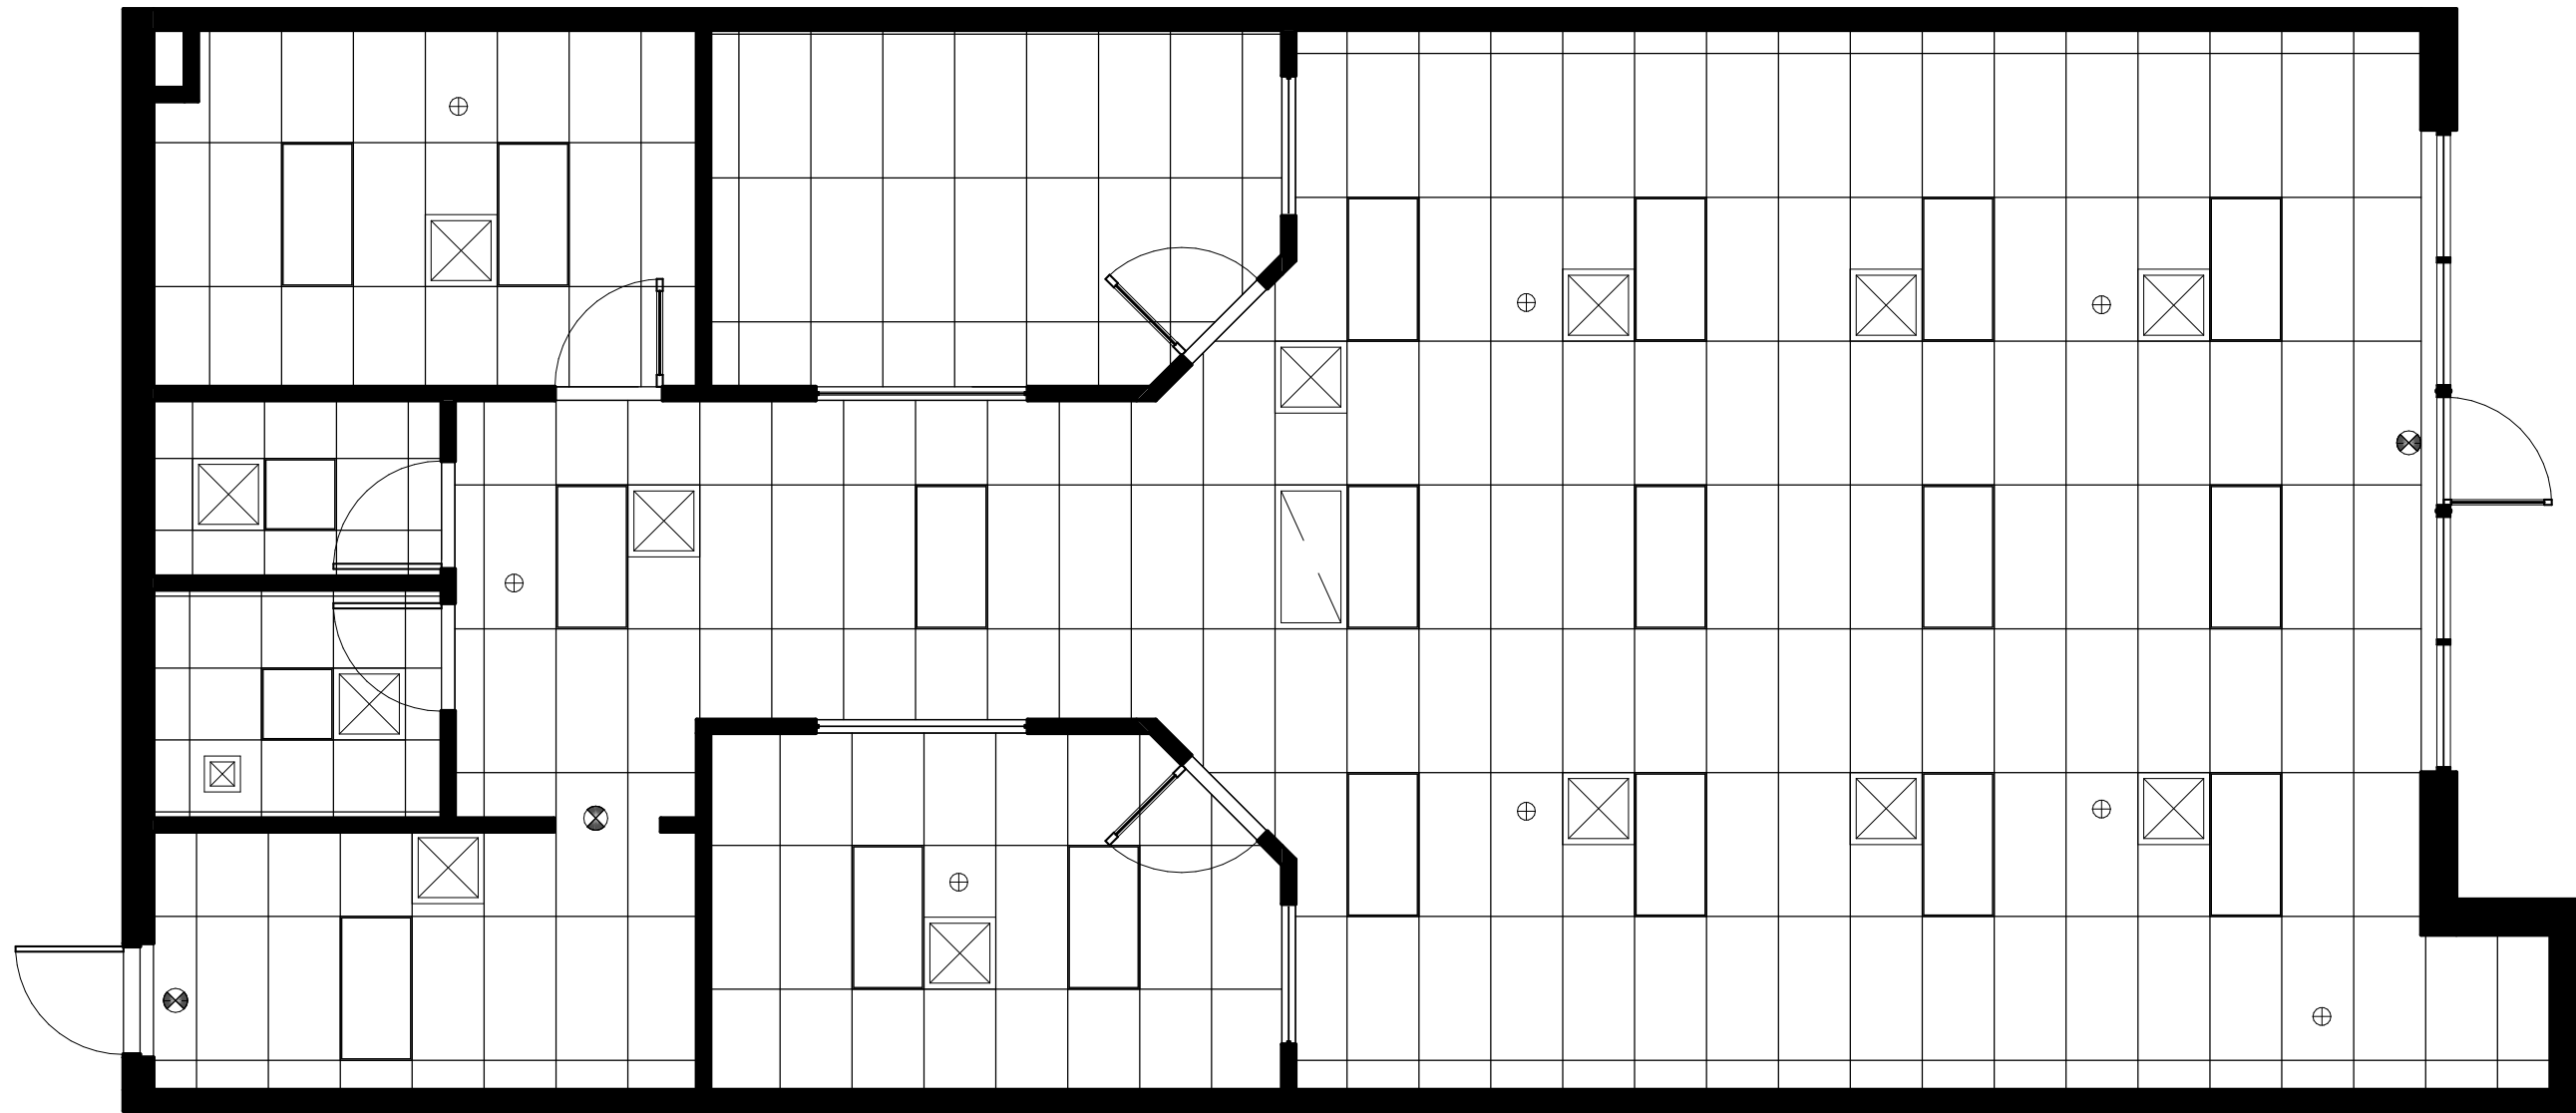

Reflected Ceiling Plan

1 1a- 1st Flr
 3/16" = 1'-0"