
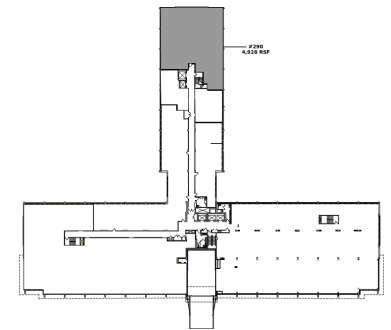


# SOUTHDALE MEDICAL CENTER I

6545 FRANCE AVENUE SOUTH EDINA, MN 55435

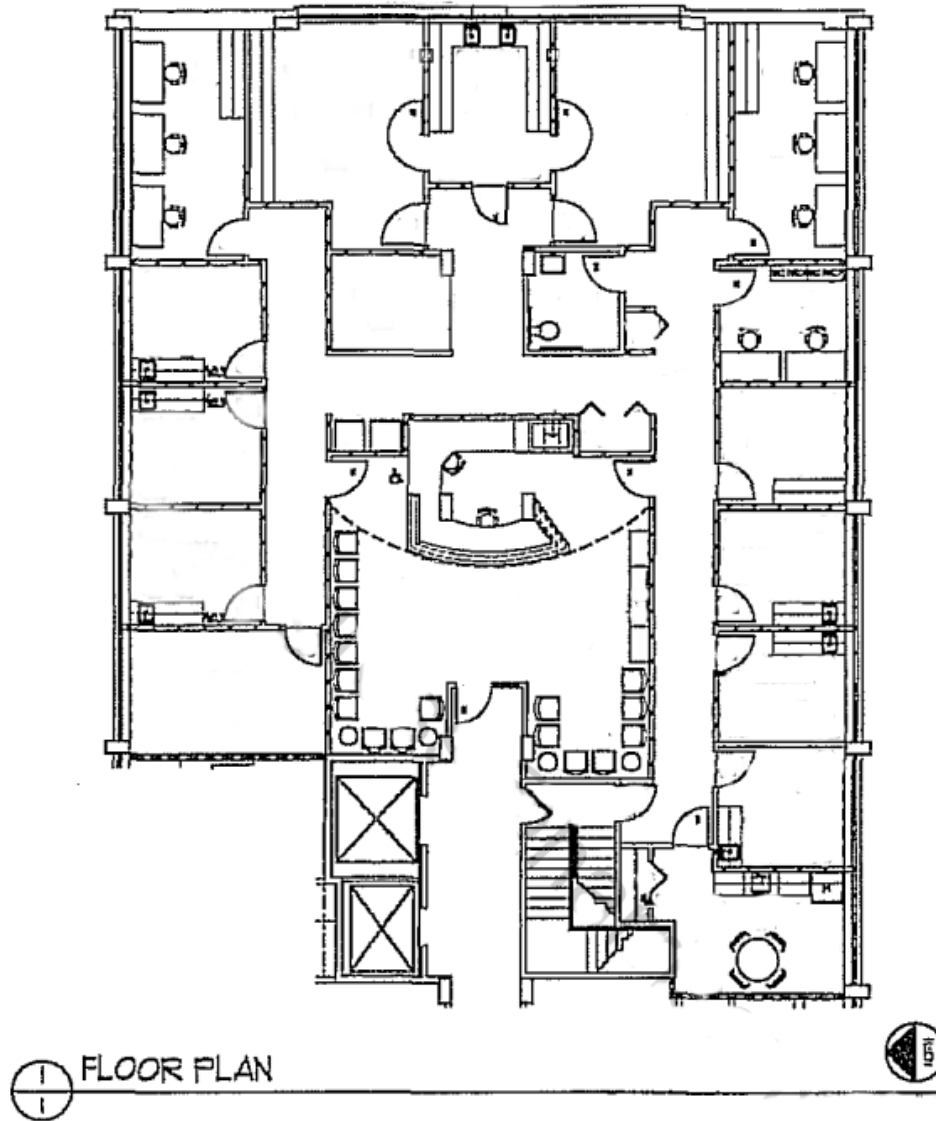

SUITE: 290

4,928 RENTABLE SQUARE FEET

Mike Fleetham  
952-767-2842 (direct)  
612-386-0993 (mobile)  
mfleetham@medcraft.com

Jolene Ludvigsen  
952-838-7126 (direct)  
612-889-7586 (mobile)  
jludvigsen@medcraft.com

NTS

Leased by:



Managed by:

