


AS-BUILT FLOOR PLAN NOT FOR CONSTRUCTION	1/8" = 1'-0" 0 4 8 12 16	SELECTED PERMITTED CONTRACT 3305 08/24/2011
---	-----------------------------	---

PARKE 33
 3305 BULLITT BOULEVARD
 ORLANDO, FL 32818

BUILDING III
SUITE 3305
 2,072 sq ft



A5-BUILT FLOOR PLAN
 THIS IS NOT A SURVEY. ALL DIMENSIONS ARE APPROXIMATE AND SUBJECT TO FIELD VERIFICATION.

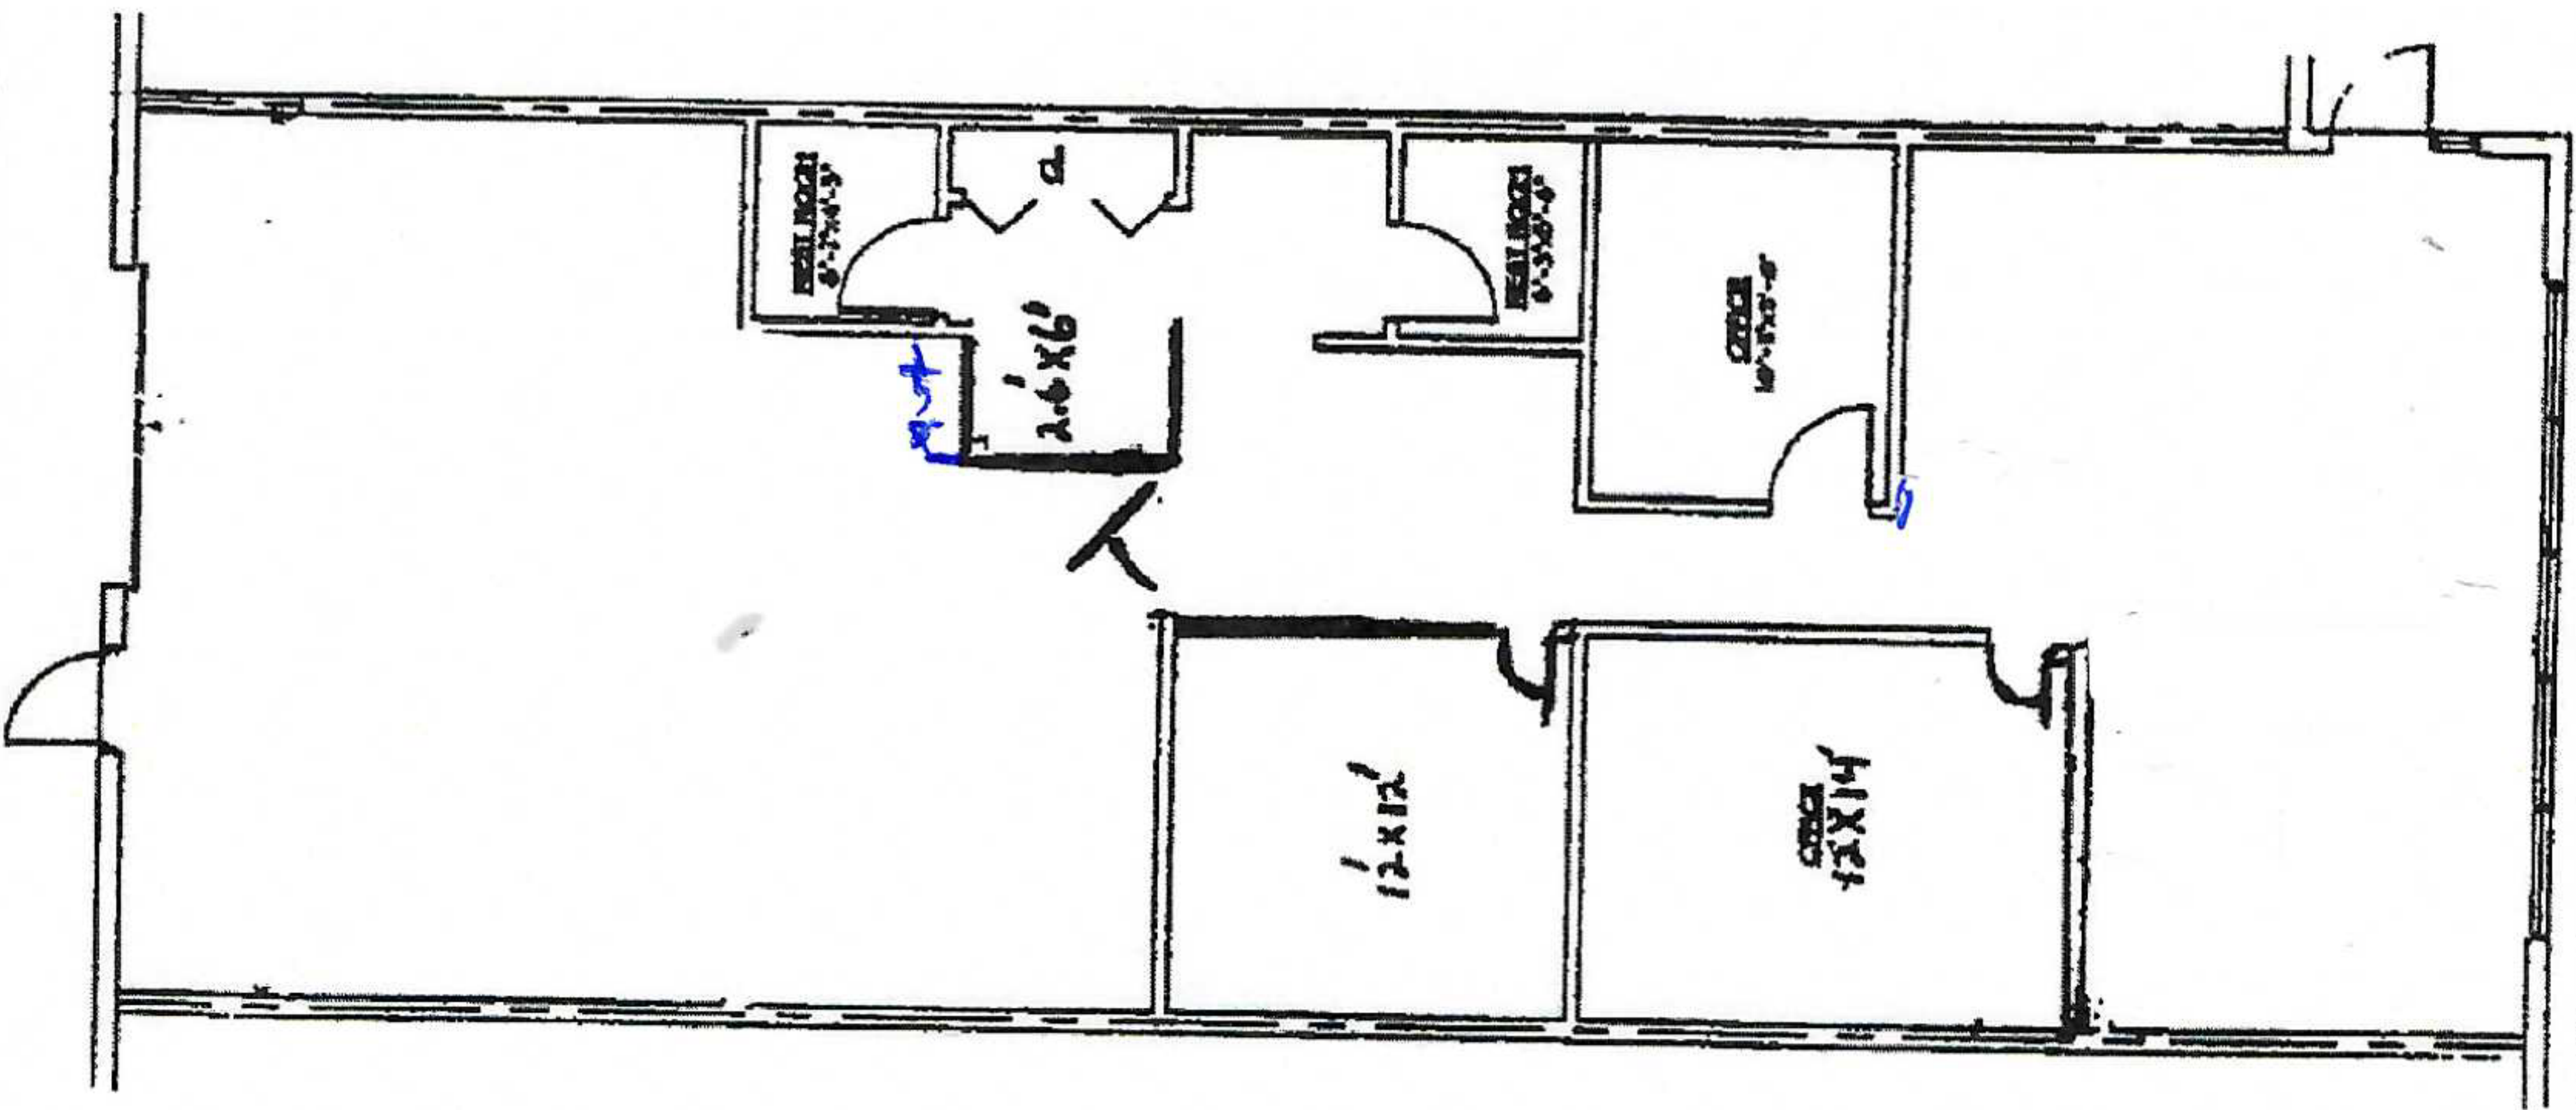

THE INFORMATION CONTAINED HEREIN IS THE PROPERTY OF THE SURVEYOR AND IS NOT TO BE REPRODUCED OR TRANSMITTED IN ANY FORM OR BY ANY MEANS, ELECTRONIC OR MECHANICAL, INCLUDING PHOTOCOPYING, RECORDING, OR BY ANY INFORMATION STORAGE AND RETRIEVAL SYSTEM, WITHOUT THE WRITTEN PERMISSION OF THE SURVEYOR.