


FOR LEASE

121 W. FORSYTH STREET

121 W. FORSYTH STREET • JACKSONVILLE, FL 32202

SUITE 620
± 1,738 SF

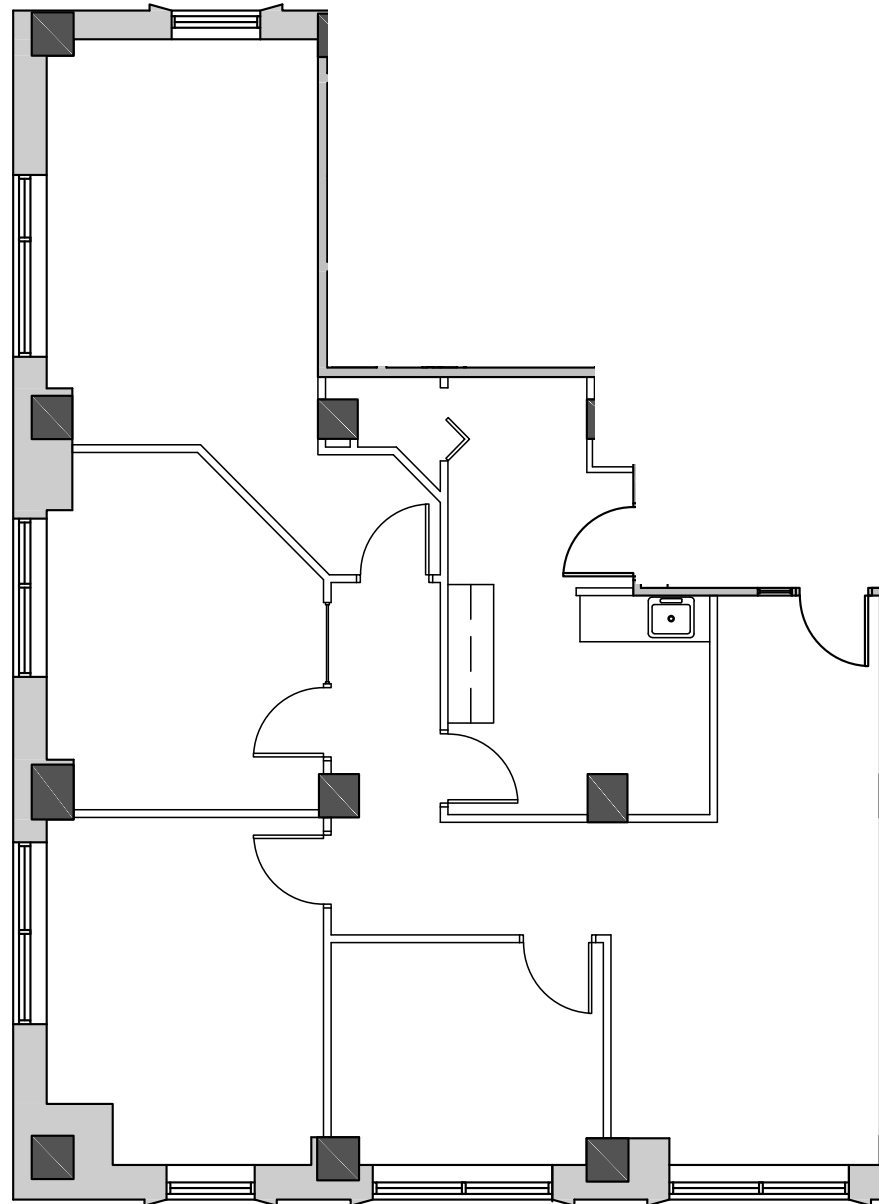

► **John Hodges**
Director of Real Estate Services
904.737.8846 x114
leasing@imc-jax.com

