


OD - OVERHEAD DOOR

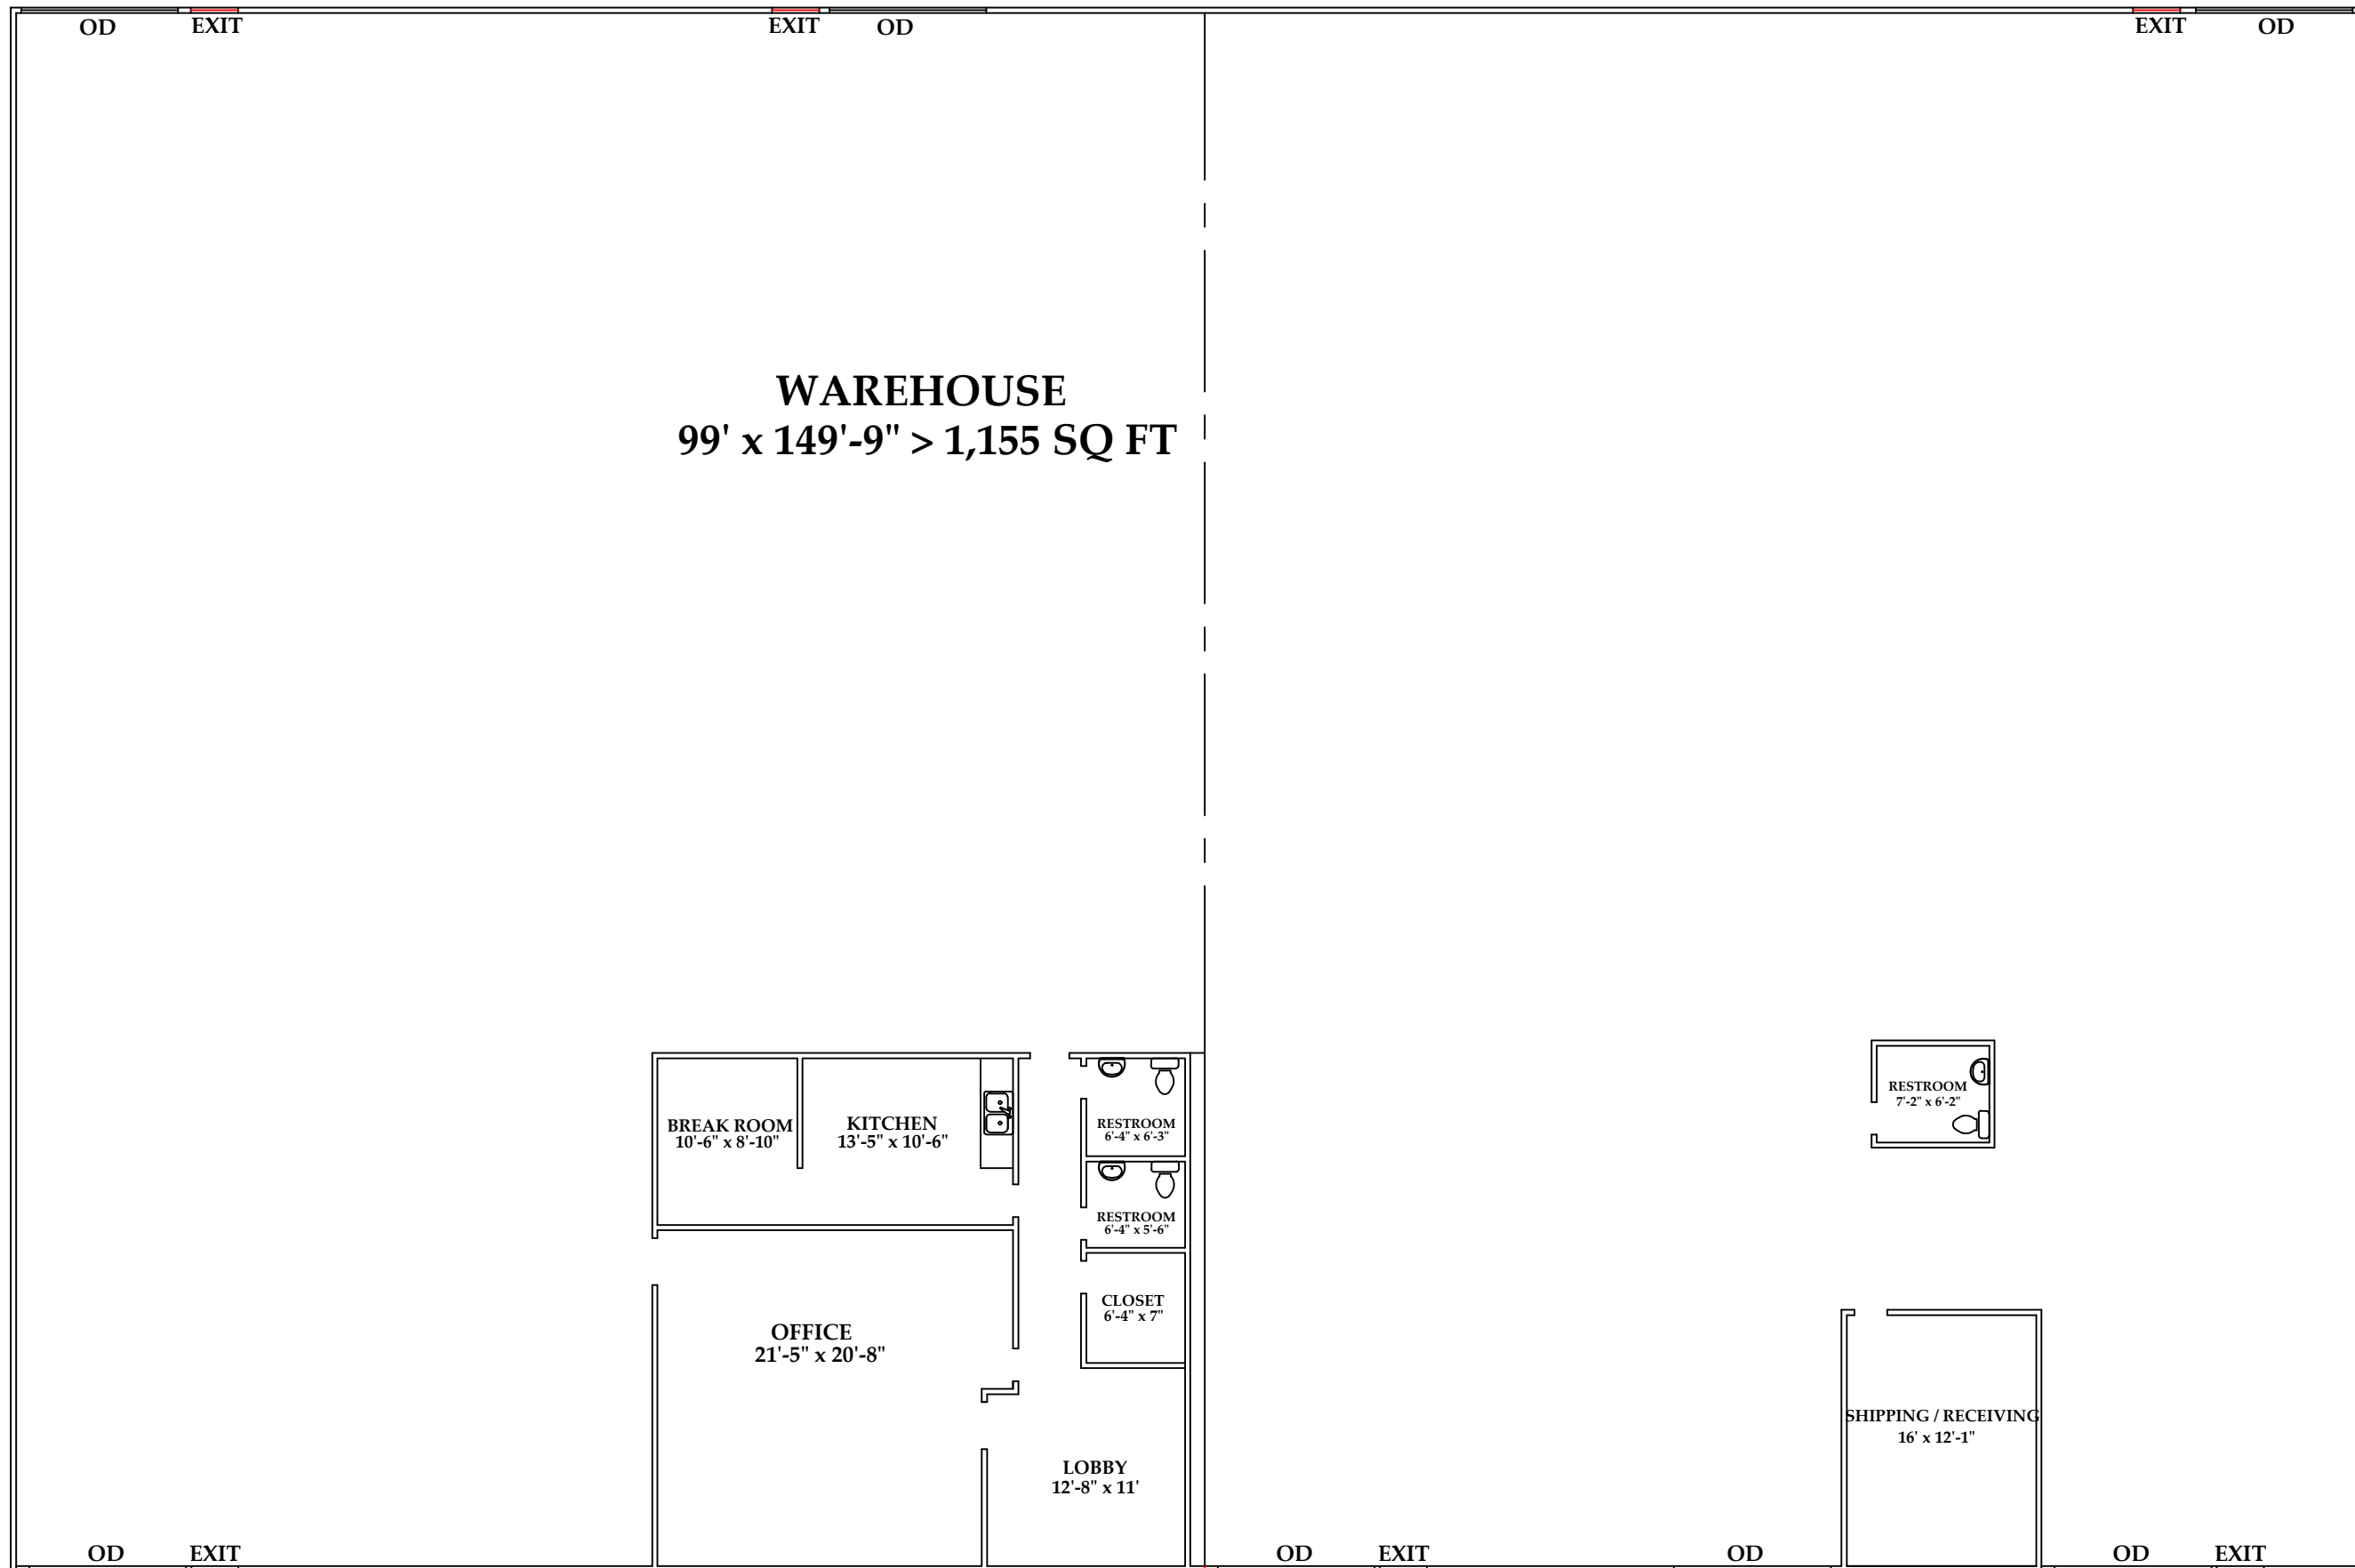

THESE PLANS ARE INTENDED TO PROVIDE THE BASIC INFORMATION NECESSARY TO OCCUPY AN EXISTING OFFICE STRUCTURE. THIS PLAN IS NOT TO BE COPIED IN ANY FORM OR MANNER

CONFLANS MANAGEMENT  
820 BUSINESS PARK SUITE 2768  
FORT WORTH, TX 76140

JOB NO.: N/A  
DRAWN BY: ROGER MONTES  
DATE: 11/7/2024  
CHECKED BY:

PLAN NO.:  
AS BUILT FLOOR PLAN

SHEET NO./FILE NAME:  
1 of 1