



GRAYMARK OFFICE BUILDING

16801 Addison Road, Addison, Texas

SUITE 400
5,303 RSF

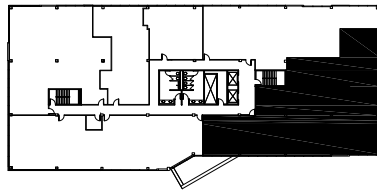

4TH FLOOR

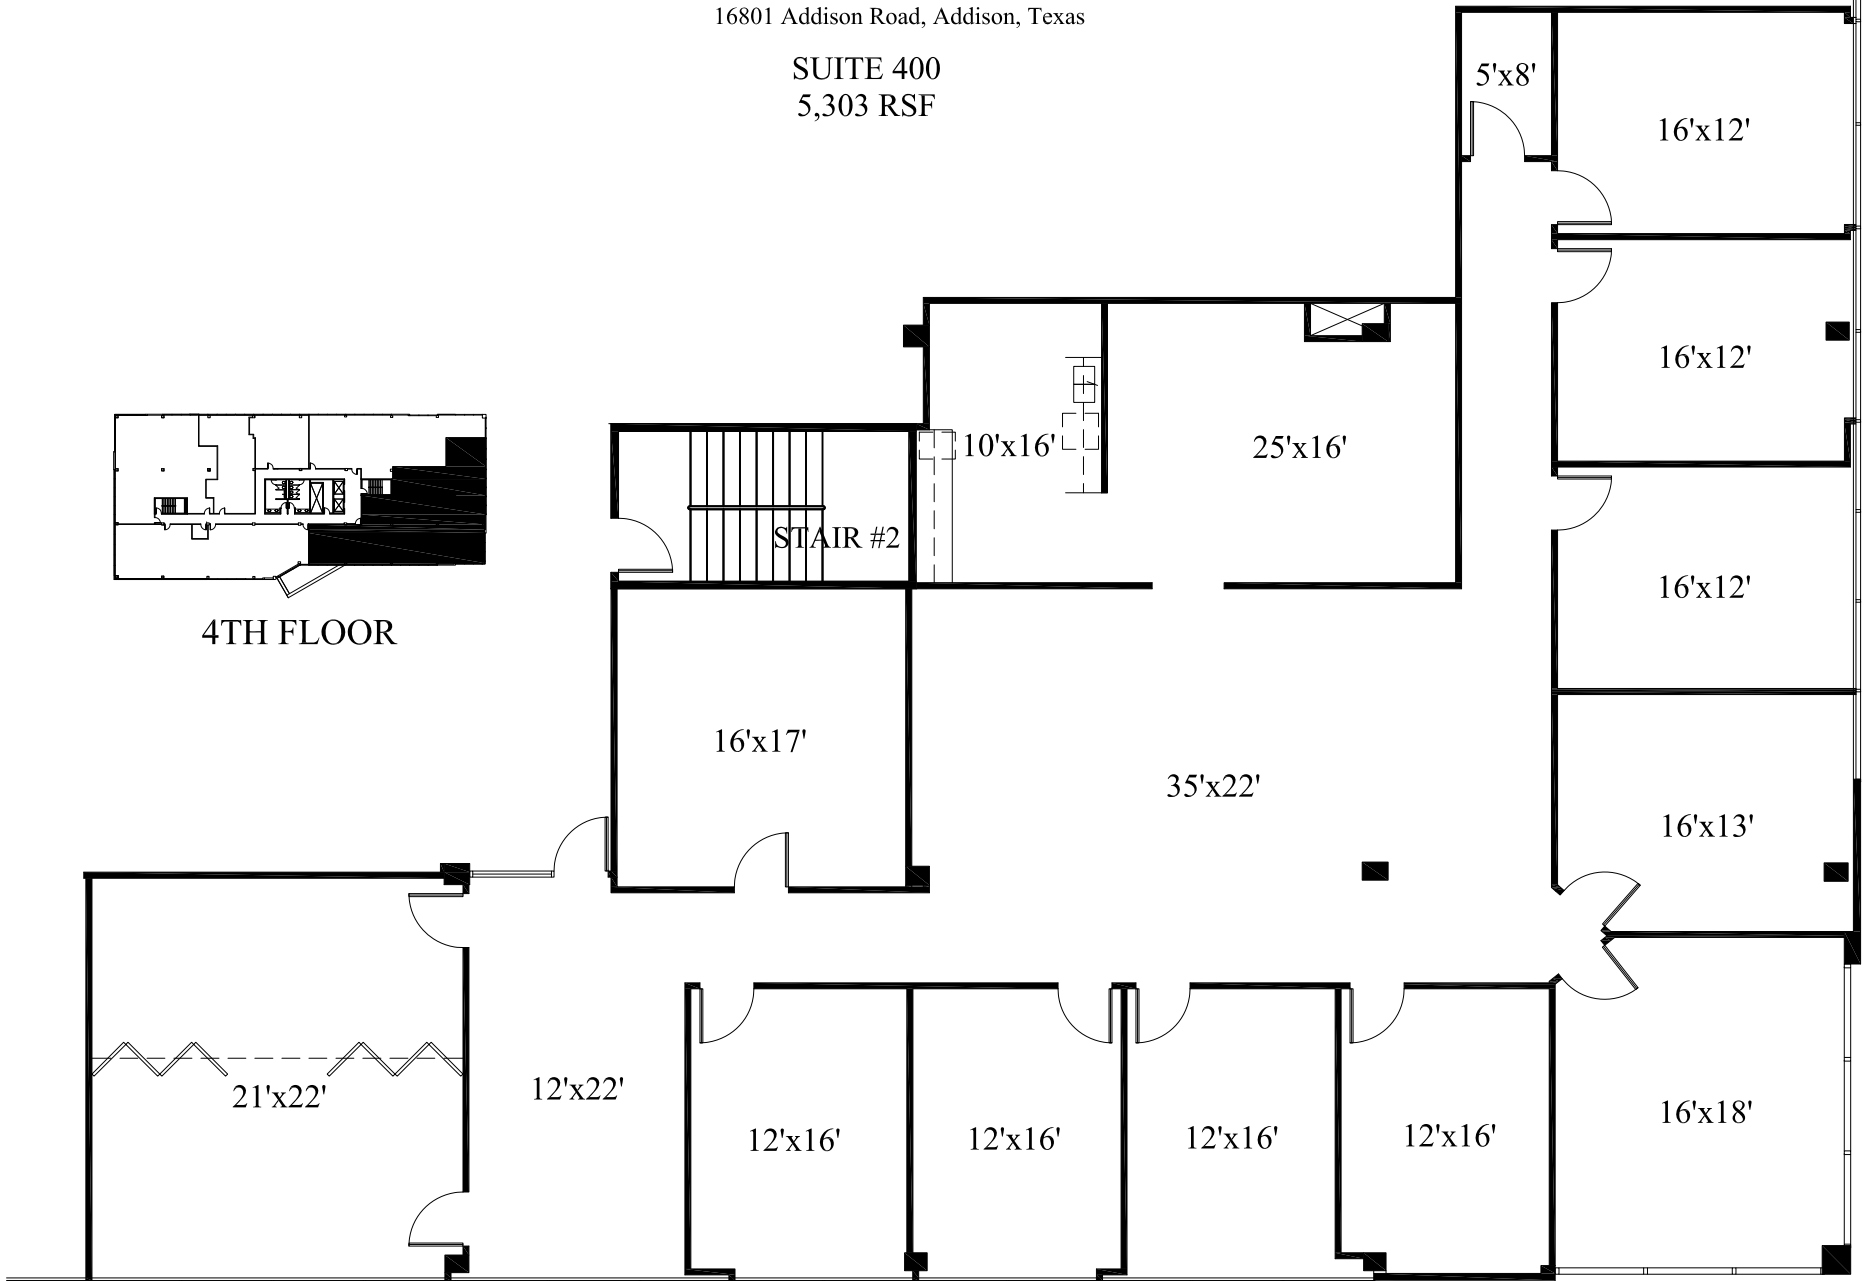

Scale: 3/32"=1'-0"

All dimensions and square footages are approximate.

January 5, 2022



THOMPSON CONSULTING SERVICES, INC. 12024 Golden Meadow Lane, Forney, Texas 75126 (972)564-5252