

Rancho Properties Leasing Guide

3065 N. Rancho Dr. Suite 104

Warehouse-1 Bay, 1 Office, 1 Reception Area, 1 Bathroom

Square Footage: 1,777

Total Monthly Costs:

	Price per Sq/Ft	Total
Base Rent:	\$ 1.25	\$ 2,221.25
CAMS:	± \$ 0.56	\$ 997.39
Taxes:	± \$ 0.12	\$ 216.65
Insurance:	± \$ 0.02	\$ 27.33
Sewer:	± \$ 0.04	\$ 66.82
Total Additional Rents:	± \$ 0.74	\$ 1,308.19
Total Monthly Rents:	\$ 1.99	\$ 3,529.44

Move In Costs:

Non-Refundable App Fee:	\$250
Security Deposit: (Equal to two months base rent)	\$ 4,442.50
Total Annual Rent :	\$ 26,655.00

Optional:Pylon Sign Rental (Per Month, Per Sign):	\$ 90.00
Optional: Parking Space(s) (Per Month, Per Space):	\$ 50.00


RANCHO #2
UNIT - 104

AREA TABULATION

SUITE 104

=

- S.F.

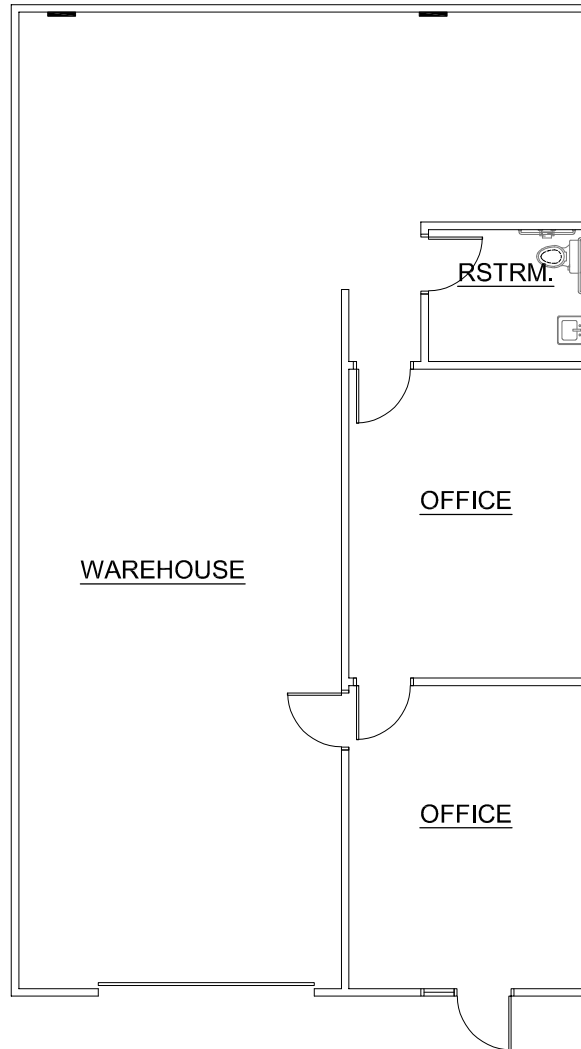

NOTES:

- (E) ELECTRICAL PANEL
- (C) DATA PANEL

- FIRE SPRINKLED - YES
- FIRE ALARMED - YES

1
A1.00

#104 AS-BUILT PLAN

SCALE: 3/32" = 1'-0"

REVISIONS	#	DATE	DESCRIPTION	DRAFTER INFORMATION	DRAFTING COMPANY:		PROJECT INFORMATION	PROJECT NAME:		DRAWING INFORMATION	PLOT DATE:		
						STREAMLINE CONCEPT DRAFTING & DESIGN, LLC		RANCHO PROFESSIONAL PLAZA			09-04-2020		
						COMPANY ADDRESS: 6935 ALIANTE PARKWAY, STE. 104-432 NORTH LAS VEGAS, NEVADA 89084		PROJECT ADDRESS: 3013 & 3065 NORTH RANCHO DRIVE LAS VEGAS, NEVADA 89130			PHASE AS-BUILT SUBMITTAL		
						COMPANY CONTACT: DYLAN YORKE - OWNER 702-416-0795		PROJECT NUMBER: 016-18002			SHEET NAME AS-BUILT FLOOR PLAN		
												SHEET NO. A1.00	